

Name

Service No.

Address

4 Barbary Rd

Location

Kind of Pipe

Size

Size of Main

Repair—Renewal—New Service

Location

Date	Material	Amount	Total	Date		Amount
------	----------	--------	-------	------	--	--------


1971	14'-6" transite					
------	-----------------	--	--	--	--	--

7-12-01	Inside installed					
---------	------------------	--	--	--	--	--

53'-6" PVC					
1-6" 22° Band					
6x6x6 wye	clean out				
4x6	CI to PVC	franco			
6x6	PVC to AC	franco			

DATE _____

TOWN OF LEXINGTON — BOARD OF PUBLIC WORKS
SEWER DIVISION

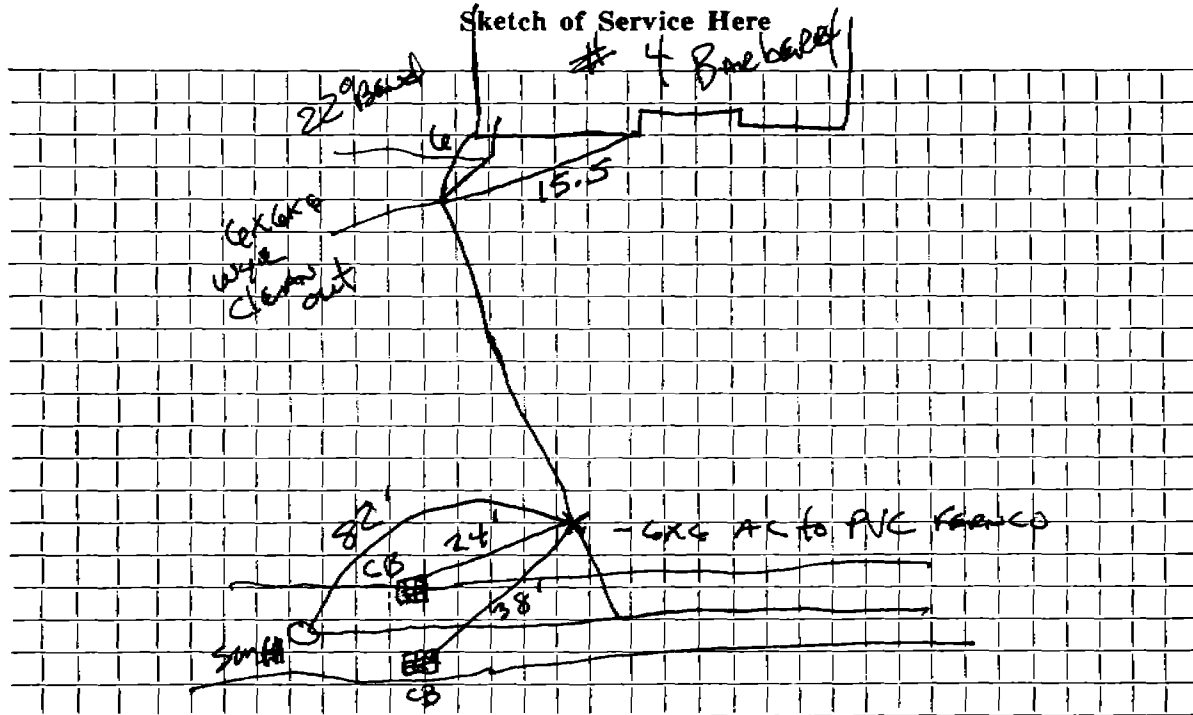

Connection made in Street. Work completed

Remarks:

.....
.....