

Name *James Owen*

Service No. 21

Address 6 Barberry Rd.

Location Lot L.C. 18

Kind of Pipe

Size

Size of Main

~~Repair Renewal~~ **New Service**

Baptiste #4577

Location **SEP 5 1986**


Date	Material	Amount	Total	Date	Amount
------	----------	--------	-------	------	--------

1971	19' 6" A.C. transite			<i>7-31-86</i>	<i>Deposit</i>	<i>228 00</i>
	pipe @ 12.00	228	00			
8/25/86	53' 6" P.V.C.					
	1 22° Bend					
	1 6" Wye					
	1 4" x 6" Fernco					
	1 6" AC to PVC Fernco					

DATE _____

TOWN OF LEXINGTON — BOARD OF PUBLIC WORKS

SEWER DIVISION

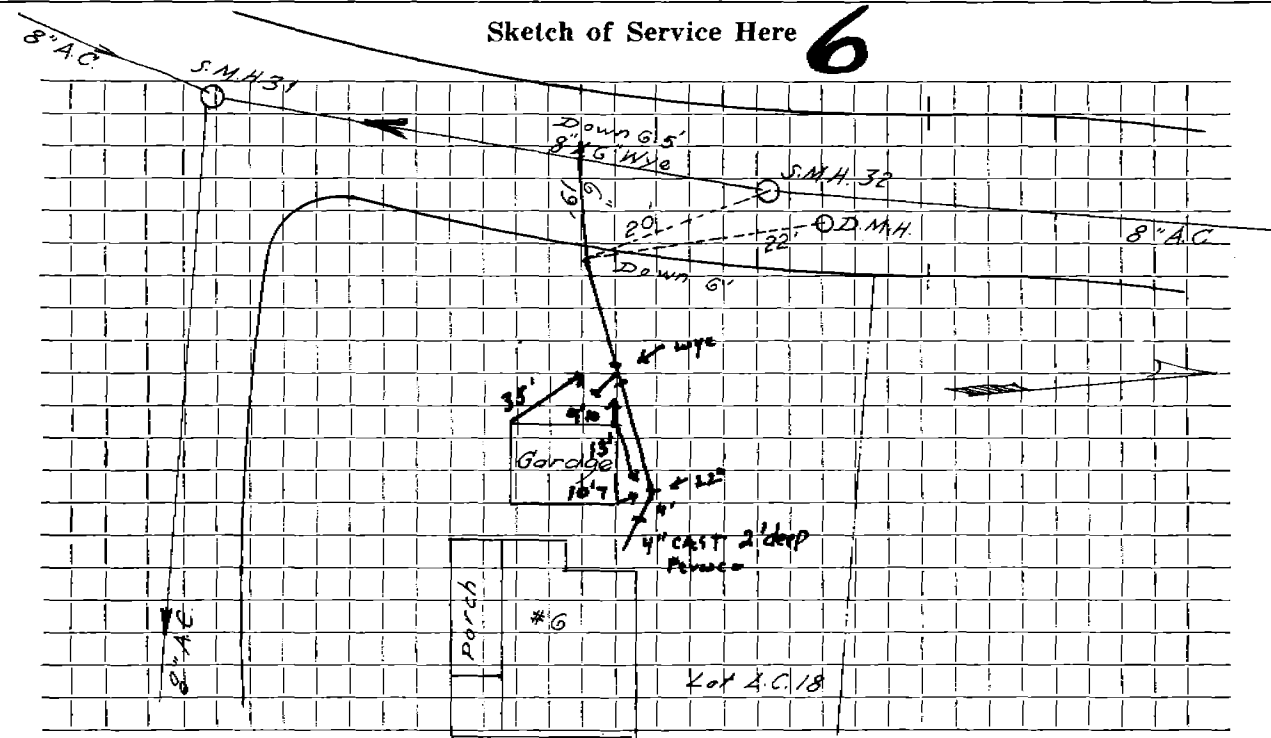

Connection made in Street. Work completed

Remarks: **2'6" STUB OUT OF WYE**

.....

.....