

Name Nick Bonanno

Service No.

Address 10 Barrett Road

Location

Kind of Pipe

Size

Size of Main

Repair—Renewal—New Service

Bonanno # 1868
Bonanno # 1689

Location


Date		Material	Amount		Total		Date	Amount	
7/27/70	20'	6" Transite pipe							
7/7/71	37'	6" Transite pipe							
	10'	4" Cast Iron							

DATE _____

TOWN OF LEXINGTON — BOARD OF PUBLIC WORKS

SEWER DIVISION

Sketch of Service Here

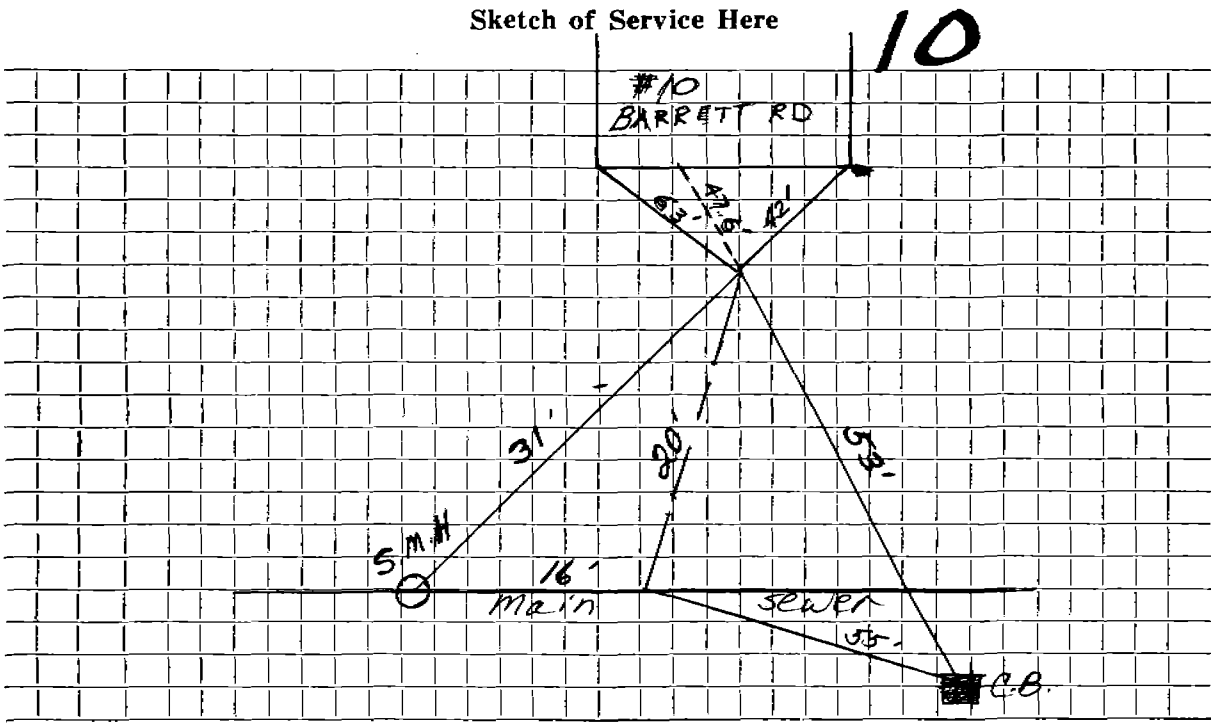

Connection made in Street. Work completed

Remarks:
.....
.....