

Name Nick Bonanno

Service No.

Address 12 Barrett Road

Location

Kind of Pipe

Size

Size of Main

Repair—Renewal—New Service

Bonanno # 1869
Bonanno # 1690

Location


Date		Material	Amount		Total	Date		Amount	
7/29/70	43'	6" Transite pipe							
7/7/71	40'	6" Transite pipe							
	10'	4" Cast Iron							

DATE _____

TOWN OF LEXINGTON — BOARD OF PUBLIC WORKS
SEWER DIVISION

Sketch of Service Here
#12 BARRETT
RD

12

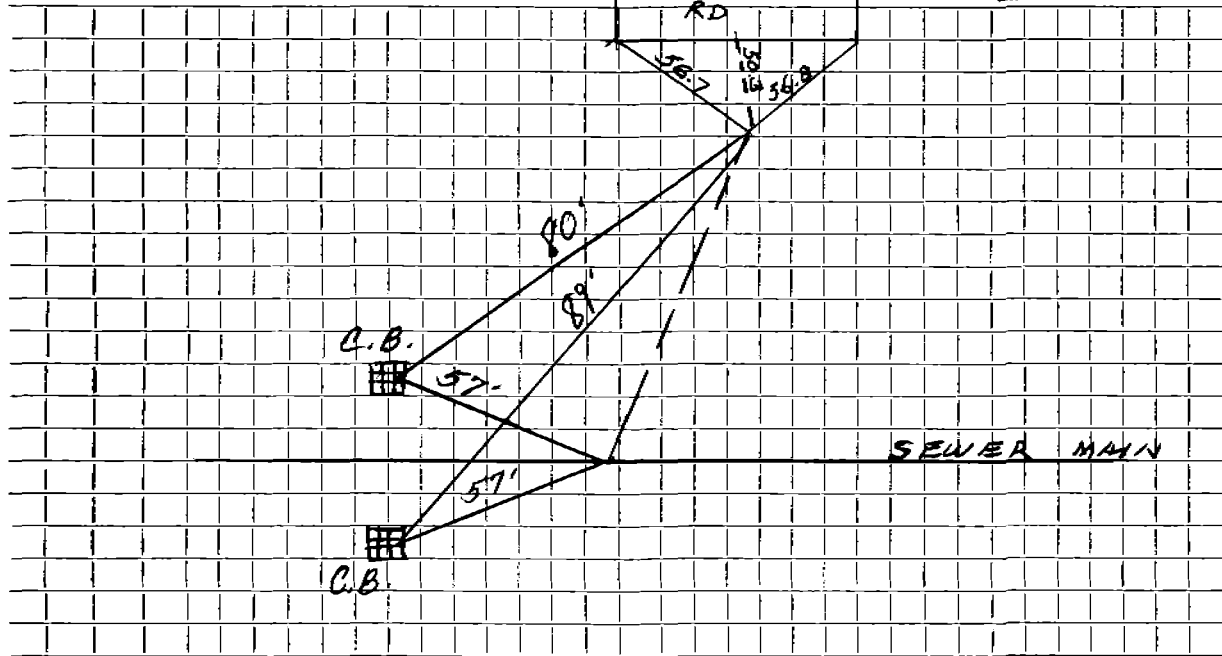

Connection made in Street. Work completed

Remarks:

.....
.....