

Name Minute Man Estates - Duffy Bros.

Service No.

Address 2 Barrett Road

Lot #240

Location

Kind of Pipe

Size

Size of Main

Repair—Renewal—New Service

Nick Bonanno Permit #A239

Location

Date

Material

Amount

Total

Date

Amount


5/25/66 32' 6" Transite pipe

DATE \_\_\_\_\_

# TOWN OF LEXINGTON — BOARD OF PUBLIC WORKS

## SEWER DIVISION

Sketch of Service Here **2**

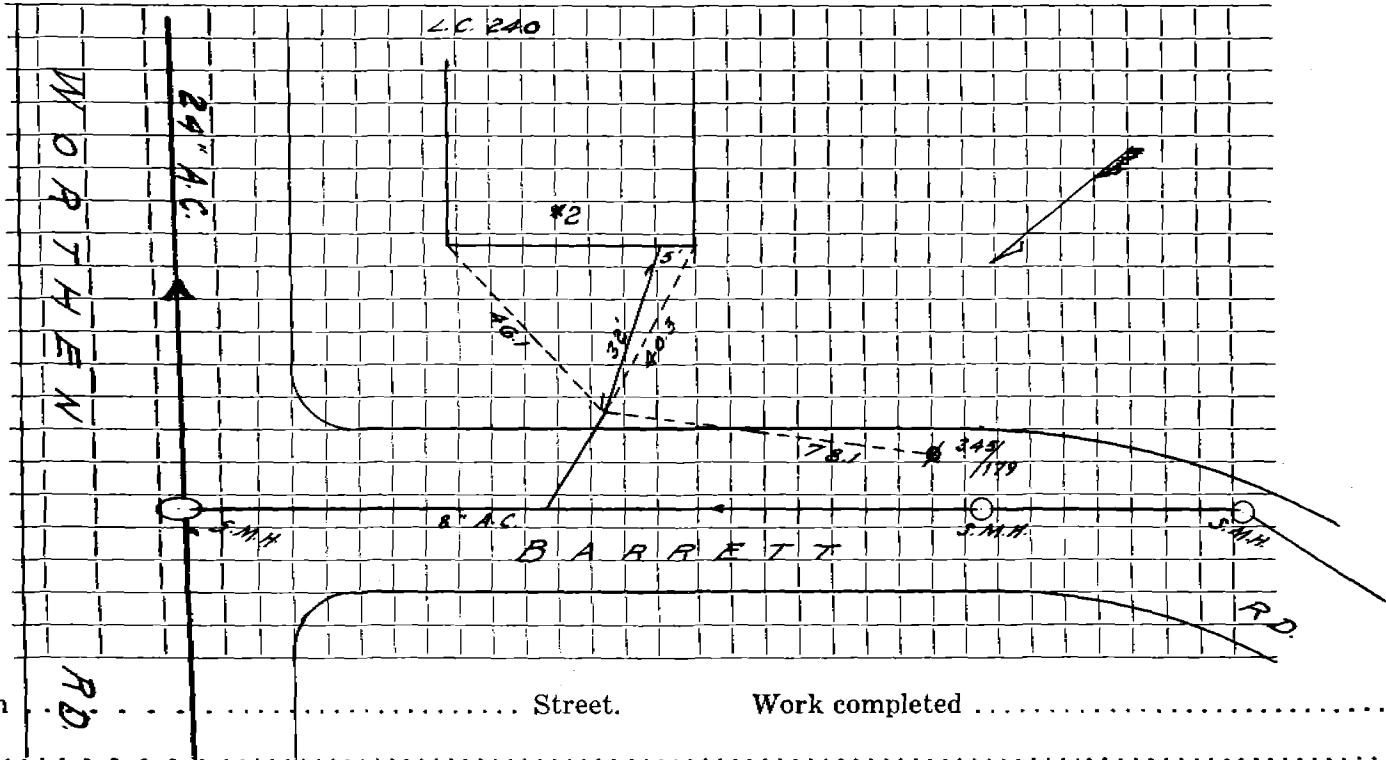

Connection made in ..... Street. Work completed .....

Remarks: .....  
.....  
.....