

Name Nick Bonanno

Service No.

Address 3 Barrett Road

Location

Kind of Pipe Bonanno # 1863

Size

Size of Main

Repair—Renewal—New Service

Bonanno #1682

Location


Date		Material	Amount		Total		Date		Amount	
7/29/70	20'	6" Transite pipe								
7/7/71	35'	6" transite pipe								
	10'	4" cast iron								

H.B.W.18501

TOWN OF LEXINGTON — BOARD OF PUBLIC WORKS
SEWER DIVISION

Sketch of Service Here

3

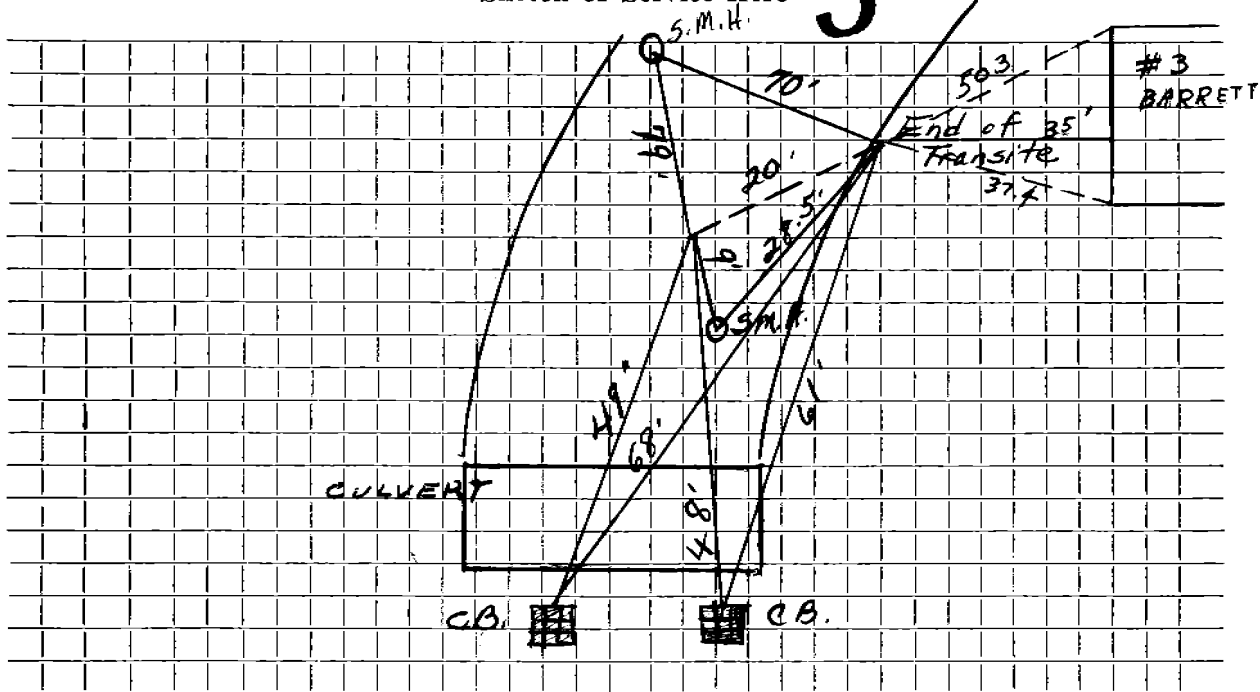

Connection made in Street. Work completed

Remarks:
.....
.....