

Name Nick Bonanno

Service No.

Address 4 Barrett Road

Location

Kind of Pipe

Size

Size of Main

Repair—Renewal—New Service

Bonanno #1864

Bonanno # 1686


Location

Date	Material	Amount	Total	Date	Amount
7/29/70	31' 6" Transite pipe				
7/7/71	23' 6" Transite pipe				
	10' Cast Iron(4")				

DATE _____

TOWN OF LEXINGTON — BOARD OF PUBLIC WORKS
SEWER DIVISION

Sketch of Service Here **4**

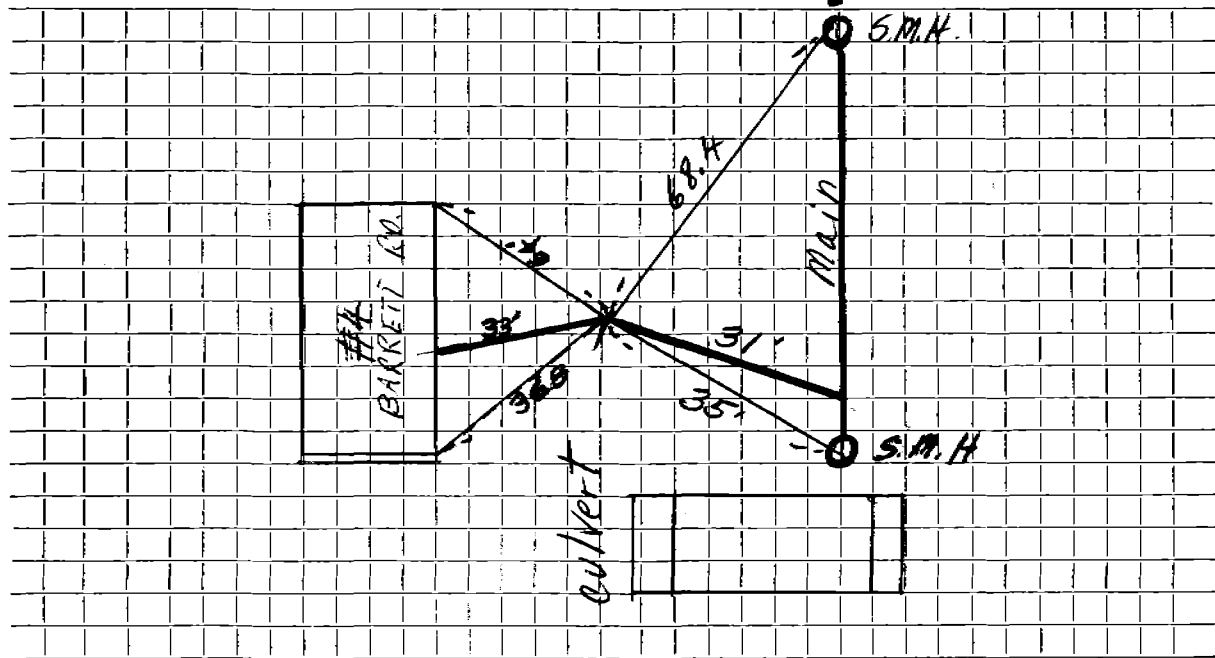

Connection made in Street. Work completed

Remarks:
.....
.....