

Name Nick Bonanno
Address 8 Barrett Road

Service No.

Location

Kind of Pipe

Size

Size of Main

Repair—Renewal—New Service

Bonanno # 1867
Bonanno # 1688

Location


Date	Material	Amount	Total	Date	Amount
7/29/70	31' 6" Transite pipe				
7/7/71	30' 6" Transite pipe				
	10' 4" Cast Iron				

TOWN OF LEXINGTON — BOARD OF PUBLIC WORKS

SEWER DIVISION

Sketch of Service Here

8

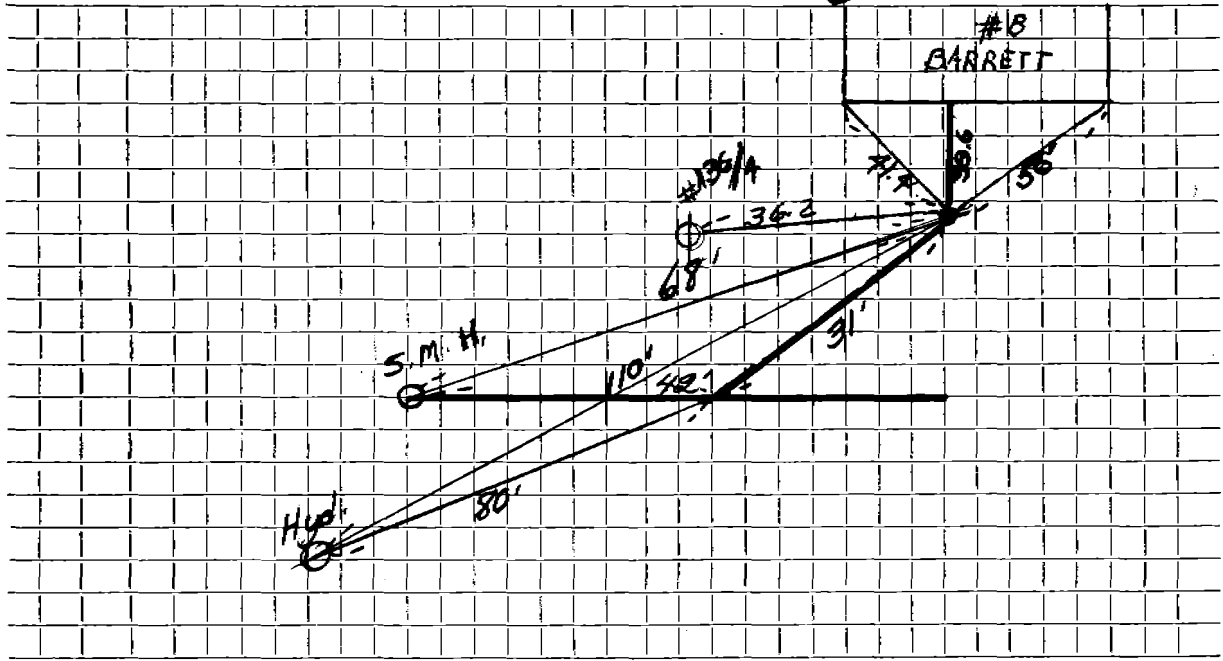

Connection made in Street. Work completed

Remarks:
.....
.....