

Name Nancy R. Hartwig

Service No. 10

Address 10 Barrymeade Drive

Location

Kind of Pipe

Size

Size of Main

Repair ~~Renewal~~ ~~NEW SERVICE~~

W.O. #0328

Location


SEP 17 1979

Date	Material	Amount	Total	Date	Amount
6/25/79	Labor 158.00			4-6-79	200.00
8/21/79	Labor 22.14	180.14		11-2-79	134.31
	10% O.H.	18.01	198.15	12-6-60	324.31
20'	6" Transite @1.91		38.20	19' 6" Transite	
1	3' Nipple		9.36	1 6" Transite Tee	
1	6" Nipple		1.93	1 6" Transite Plug	
1	1' Nipple		2.76	2 1 1/4" Transite Elbow	
1	5' Nipple @2.33		11.65		
1	4" Donut		3.05		
1	1 1/4" Elbow		4.15		
4	Hrs. Backhoe @6.50		26.00		
4	Hrs. Trucking @3.00		12.00		
3	Yds. Loam @5.44		16.32		
1	Lb. Seed		.74		
5-20-63	Renewal		324.31		
60'	6" Transite			4-15-69	Roots

DATE _____

TOWN OF LEXINGTON — BOARD OF PUBLIC WORKS
SEWER DIVISION

Sketch of Service Here

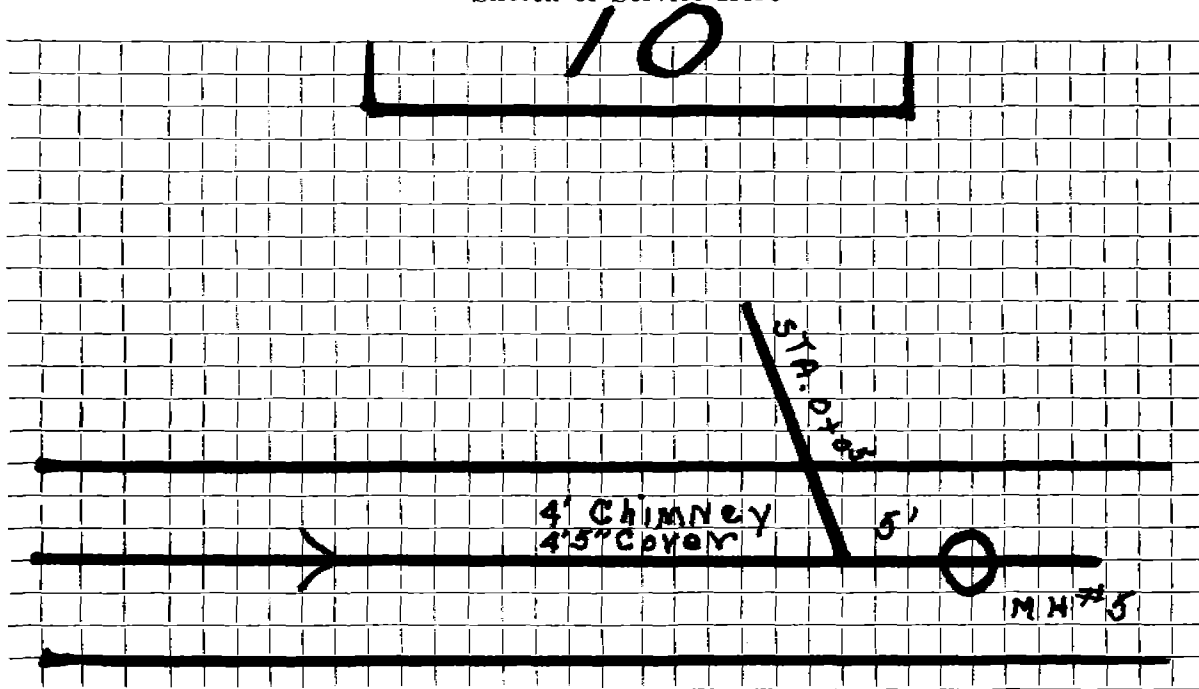

Connection made in Street. Work completed

Remarks:

.....

.....