

Name

Rabinowitz

Service No.

Address

11 BARRYMEADE DRIVE

DRAIN

Location

Kind of Pipe

Size

Size of Main

Repair—Renewal—New Service

Suburbanite 2 1/2

Location

Date

Material

Amount

Total

Date

Amount

4/22/91

5 LF 4" PVC

166 LF 6" PVC

NEW C.B.

9 LF 6" PVC


2- 6" FERNCOS

DATE _____

TOWN OF LEXINGTON — BOARD OF PUBLIC WORKS

SEWER DIVISION
DRAIN

Sketch of Service Here

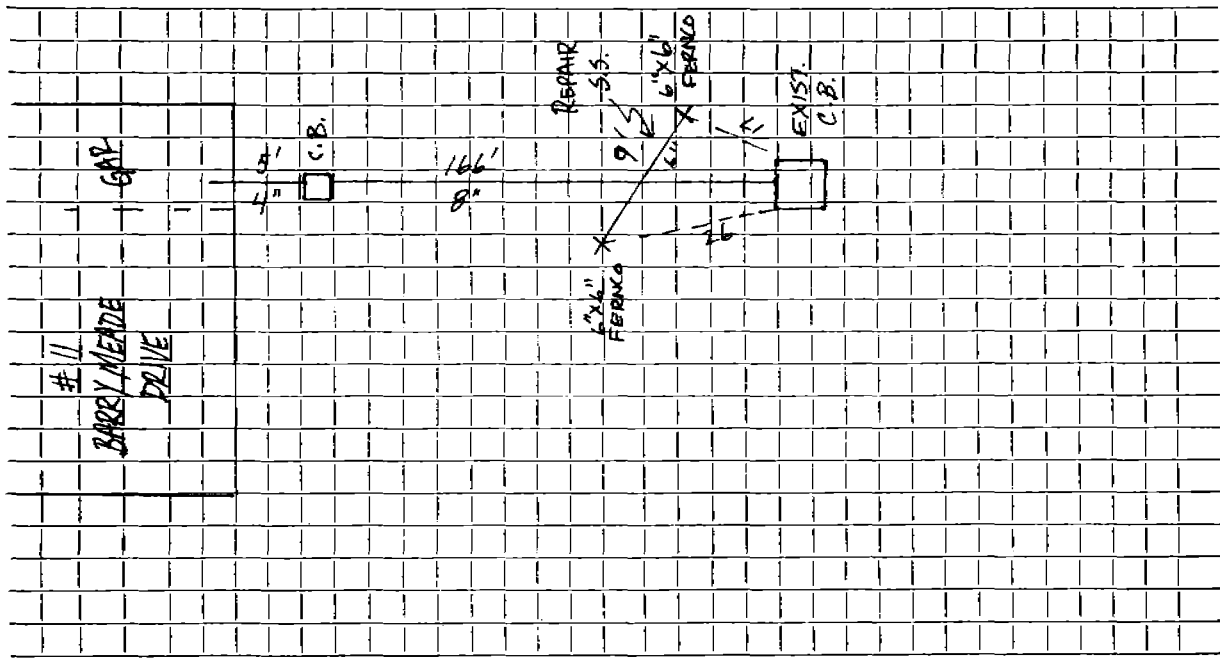

Connection made in Street. Work completed ... 4/22/91 SUBURBICITE.....

Remarks:
.....
.....

Name Herman VanSchuyver

Service No. 265

Address 11 Barrymeade Drive

Location

Kind of Pipe

Size

Size of Main

~~Repair or Renewal~~ New Service

Location *Cimm 3-6-61*

Date	Material	Amount	Total	Date	Amount
11-30-60	Labor	90.02		11-23-60	450.00
12-1-60	"	97.15		3-21-61	58.66
12-2-60	"	18.68	205.85		508.66
	10% O.H.	20.59	226.44		
195	6" Transite pipe @.78		152.10		
16	3/4 ton 1 1/2" Stone @1.50		24.37		
1	6" Transite Tee		4.21		
2	6" 11 1/2° Transite Elbow @2.24		4.48		
2	22 1/2° Transite Bend @6.21		12.42		
1	22 1/2" Transite Elbow		2.24		
1	90° Transite Elbow		5.40		
20	x 3 Patch		20.00		
6	hrs. Town Shovel @6.50		39.00		
6	hrs. Trucking @3.00		18.00		
			508.66		

DATE _____

TOWN OF LEXINGTON — BOARD OF PUBLIC WORKS
SEWER DIVISION

Sketch of Service Here



Connection made in Street. Work completed

Remarks:
.....
.....