

Name C.H. MacDonald

Service No. 289

Address 12 Barrymeade Drive

Location

Kind of Pipe

Size

Size of Main

~~Repair~~ ~~Renewal~~ New Service


Location Conn 12-31-60

Date	Material	Amount	Total	Date	Amount
12-27-60	Labor	97 32		12-9-60	Deposit 250 00
	10% O.H.	<u>9 73</u>	107 05	12-31-60	Retard 3 00
	78' 6" Transite pipe @78		60 84		246 95
	1 22 $\frac{1}{2}$ ^o Transite Elbow		2 24		
	2 22 $\frac{1}{2}$ ^o Transite Bends @6.21		12 42		
	1 6" 90 ^o Transite Elbow		5 40		
	21 x 3 Patch		21 00		
	4 Hrs. Town Shovel @6.50		26 00		
	3 Hrs. Trucking @3.00		9 00		
	1 Hr. Rogers Trailer @3.00		<u>3 00</u>		
			246 95		

DATE _____

TOWN OF LEXINGTON — BOARD OF PUBLIC WORKS
SEWER DIVISION

Sketch of Service Here **12**

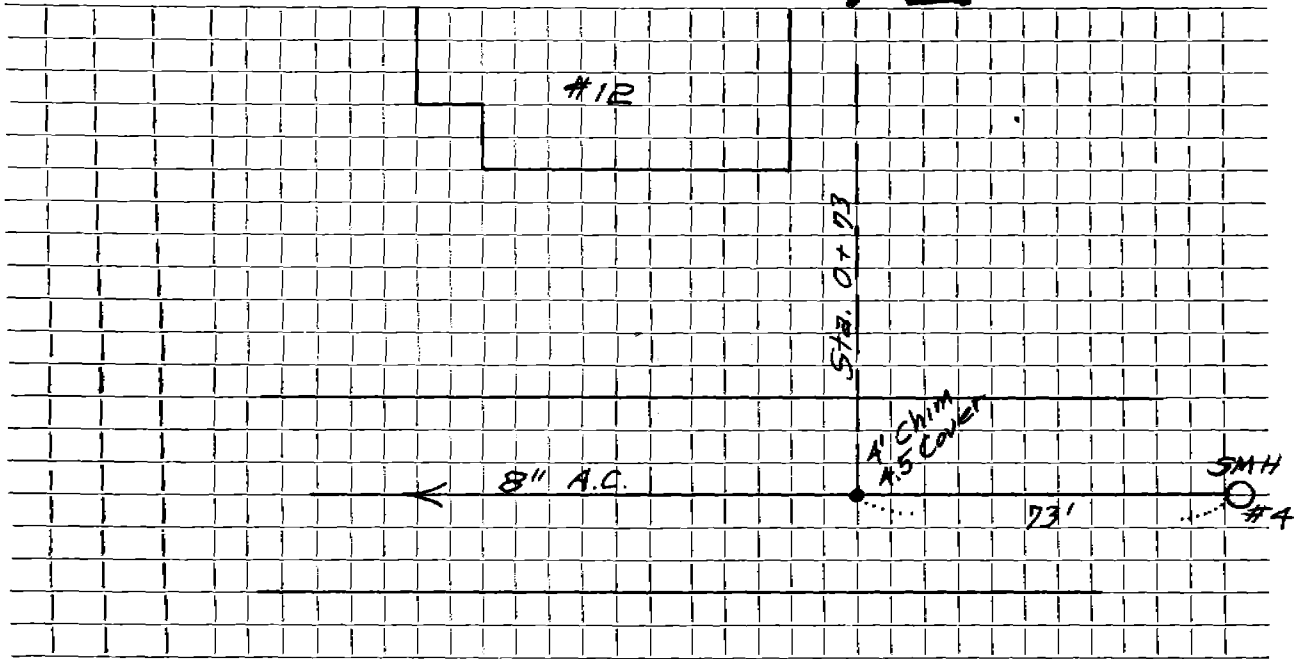

Connection made in Street. Work completed

Remarks:
.....
.....