

Name Roy Aalerud

Service No. 288

Address 3 Barrymeade Drive

Location

Kind of Pipe

Size

Size of Main

~~Repair/ Renewal~~ - New Service

Location *Comm 5-8-61*

Date	Material	Amount	Total	Date		Amount
3-20-61	Labor	97.81		<i>12-9-61</i>	<i>Deposit</i>	<i>200.00</i>
4-8-61	"	33.58	131.39	<i>5-22-61</i>	<i>Paid</i>	<i>58.06</i>
	10% O.H.	13.14	144.53			<i>258.06</i>
64'	6" Transite pipe @.78		49.92			
1	ton 3/4" Stone @1.50		1.50			
1	22 1/2° Transite Bend		6.21			
1	6" 90° Elbow Transite		5.40			
3	hrs. Town Shovel @6.50		19.50			
4	hrs. Trucking @3.00		12.00			
1	hr. Trailer @3.00		3.00			
1	hr. Pumping @1.00		1.00			
15	x 3 Patch		15.00			
			258.06			


5-22-61

DATE _____

TOWN OF LEXINGTON — BOARD OF PUBLIC WORKS
SEWER DIVISION

Sketch of Service Here

3

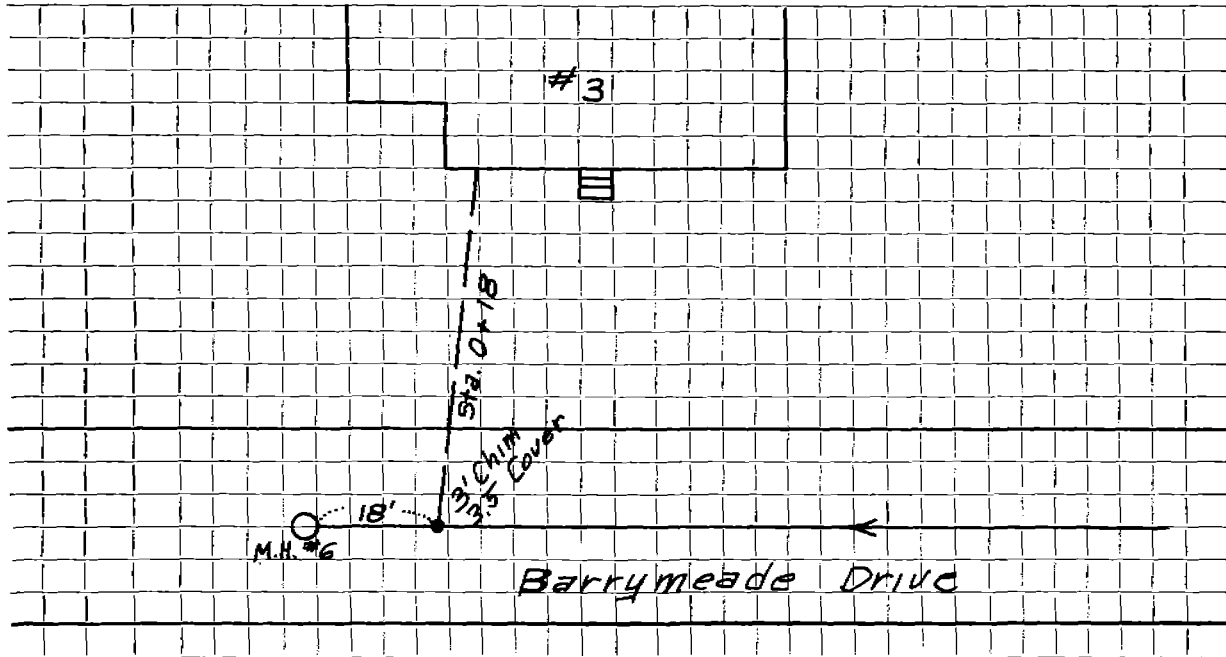

Connection made in Street. Work completed

Remarks:

.....
.....