

Name Burton H. Harrison

Service No. 268

Address 4 Barrymeade Drive

Location

Kind of Pipe

Size

Size of Main

~~Repair/Replacement~~ New Service

Location Comm 12-31-60


Date	Material	Amount	Total	Date	Amount
12-7-60	Labor	97.15		11-29-60	200.00
12-8-60	"	52.31	149.46	1-8-61	102.98
	10% O.H.	14.95	164.41		302.98
	58' 6" Transite pipe @.78		45.24		
	11 ton 3/4" Stone @1.50		16.50		
	7 ton Gravel @.85		5.95		
	2 11 1/2" Transite Elbow @2.24		4.48		
	1 6" 90° Transite Elbow		5.40		
	4 hrs. Townshovel @6.50		26.00		
	4 hrs. Trucking @3.00		12.00		
	3 hrs. Pumping @1.00		3.00		
	20 x 3 Patch		20.00		
			302.98		

DATE \_\_\_\_\_

TOWN OF LEXINGTON — BOARD OF PUBLIC WORKS  
SEWER DIVISION

Sketch of Service Here

4

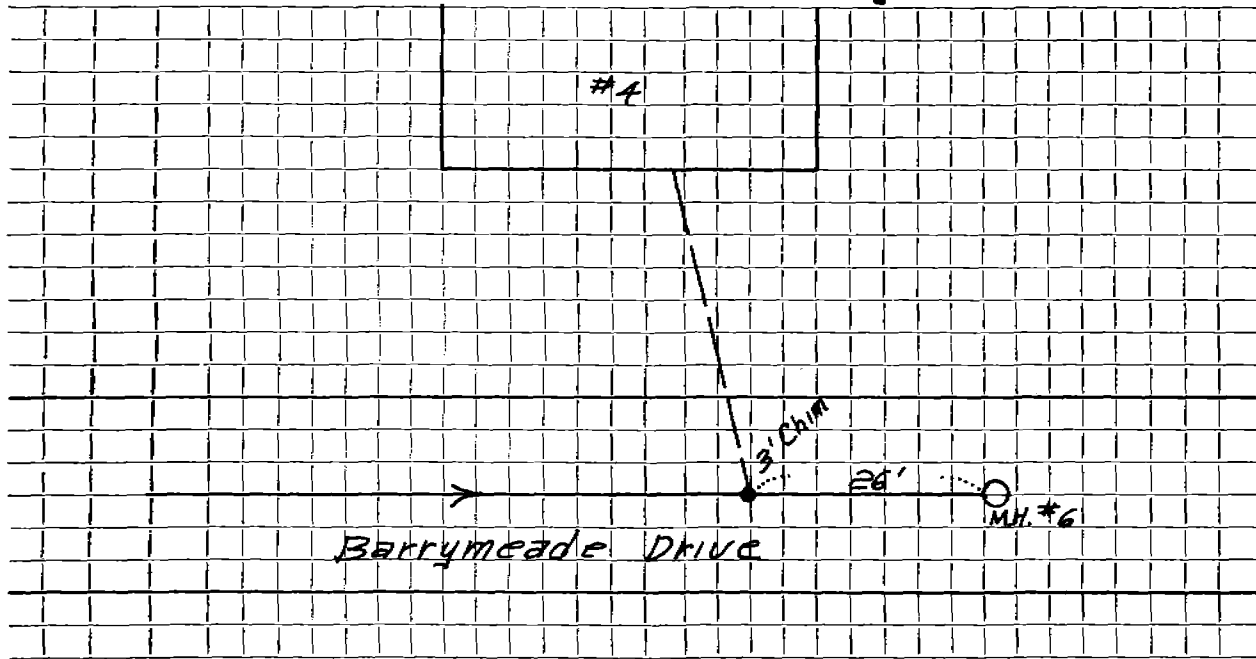

Connection made in ..... Street. Work completed .....

Remarks: .....  
.....  
.....