

Name John H. Butler

Service No. 272

Address 5 Barrymeade Drive

Location

Kind of Pipe

Size

Size of Main

~~Repair~~ ~~Renewal~~ — New Service

Location *Comm 12-31-60*


Date	Material	Amount	Total	Date	Amount
12-8-60	Labor	44 84		12-1-60	400 00
12-9-60	"	97 15		3-14-61	31 16
12-10-60	"	37 84	179 83		431 16
	10% Overhead		17 98		
	160' 6" Transite pipe @78		124 80		
	29 Ton Bank Gravel @85		24 65		
	1 6" 90° Elbow		5 40		
	3 Hrs. Town Shovel @6.50		19 50		
	5 Hrs. Trucking @3.00		15 00		
	1 Hr. Loader @3.00		3 00		
	10 x 3 Patch Street		10 00		
	31 x 3 Patch Driveway		31 00		
			431 16	10-29-66	Roots
				4-6-66	Roots + Paper
				11-26-66	Roots

DATE \_\_\_\_\_

TOWN OF LEXINGTON — BOARD OF PUBLIC WORKS  
SEWER DIVISION

Sketch of Service Here

5

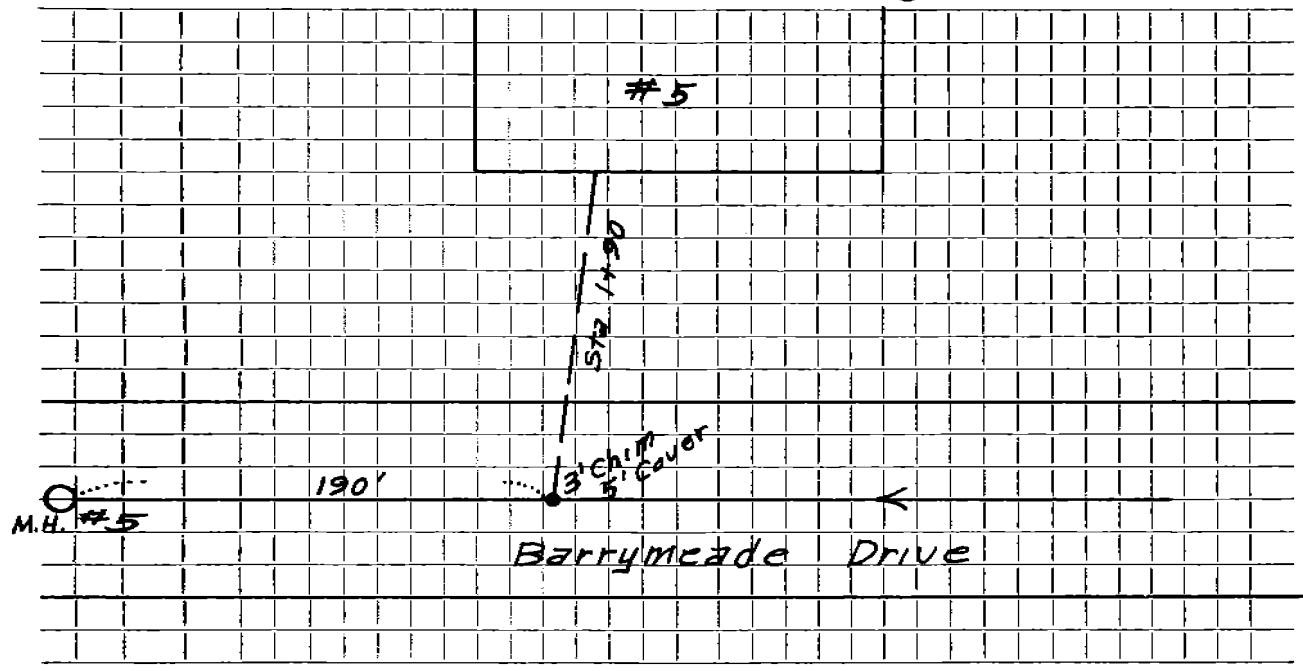

Connection made in ..... Street. Work completed .....

Remarks: .....  
.....  
.....