

Name Donald Shaw

Service No. 256

Address 6 Barrymeade Drive

Location

Kind of Pipe

Size

Size of Main

~~Repair~~ ~~Renewal~~ New Service

Location

*Conn 3-6-61*


Date	Material	Amount	Total	Date		Amount
12-2-60	Labor	78.47		11-16-60	Deposit	200.00
	10% O.H.	7.85	86.32	3-6-61	Retard	9.72
	57' 6" Transite pipe @.78		44.46			190.08
	1 6" 90° Transite Elbow		5.40			
	1 11 1/4° Transite Elbow		2.24			
	7 1/2 ton Gravel @.85		6.16			
	6 3/4" Stone @1.50		9.00			
	17 x 3 Patch		17.00			
	3 hrs. Town Shovel @6.50		19.50			
			190.08			

DATE \_\_\_\_\_

TOWN OF LEXINGTON — BOARD OF PUBLIC WORKS  
SEWER DIVISION

Sketch of Service Here

6

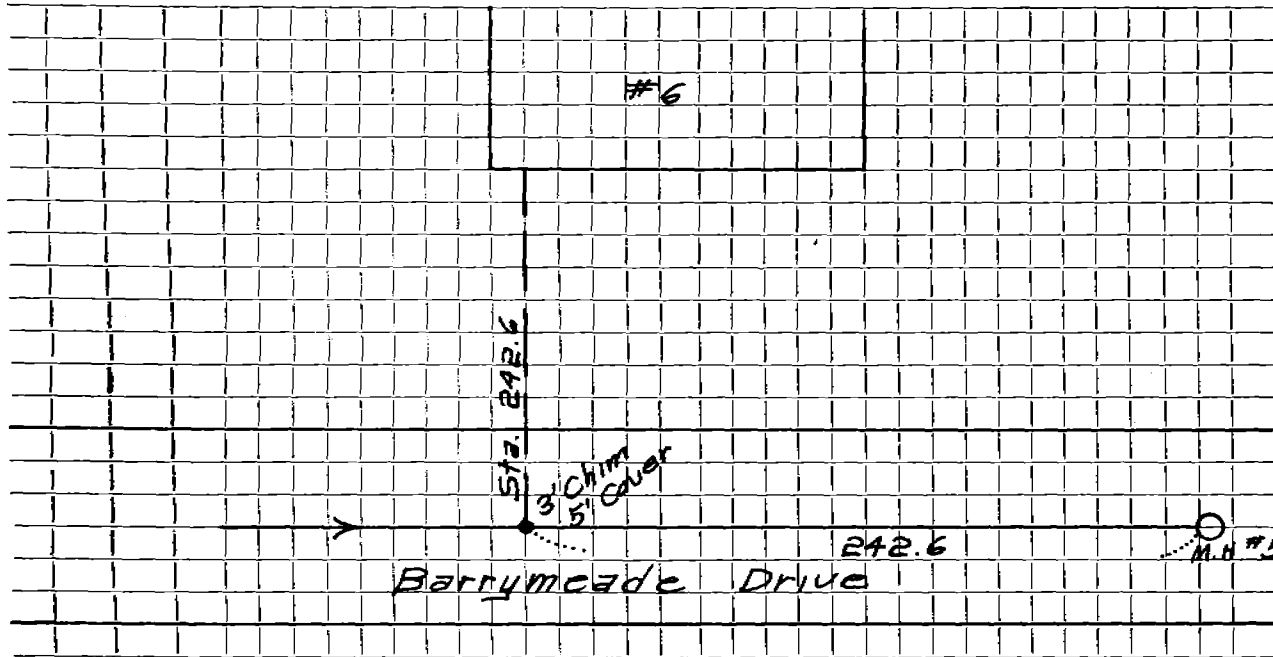

Connection made in ..... Street. Work completed .....

Remarks: .....  
.....  
.....