

Name Neal Zierler

Service No. 192

Address 7 Barrymeade Drive

Location

Kind of Pipe

Size

Size of Main

~~Revised Record~~ New Service

WO # 7006

Location


Comm 2-26-62

Date	Material	Amount	Total	Date	Amount
12-15-61	Labor	87.45		12-14-61	Deposit 500.00
	10% C.H.	8.75	96.20	2-26-62	Refund 206.83
147	6" Transite pipe @.78		114.66		293.17
1	22 ¹ / ₂ " Transite Bend		6.21		
1	11 ¹ / ₄ " Transite Bend		5.10		
4	hrs. Town Shovel @6.50		26.00		
3	hrs. Trucking @3.00		9.00		
1	hr. Trailer @3.00		3.00		
1	hr. Loader @3.00		3.00		
15	x 3 Patch		15.00		
	Spring Loam & Seeding		15.00		
			293.17		

DATE _____

TOWN OF LEXINGTON — BOARD OF PUBLIC WORKS
SEWER DIVISION

Sketch of Service Here **7**

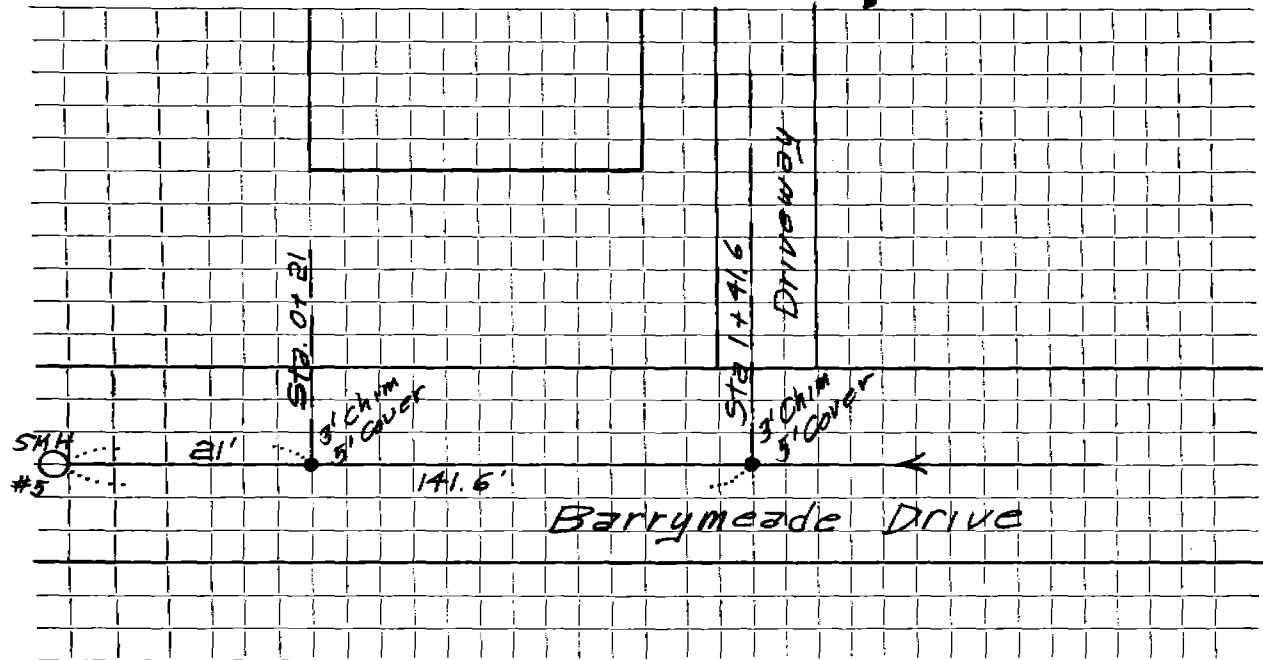

Connection made in Street. Work completed

Remarks:
.....
.....