

Name Elsa G. Backer

Service No. 290

Address 8 Barrymeade Drive

Location

Kind of Pipe

Size

Size of Main

~~Repair - Renewal~~ New Service

Location


Comp 5-8-61

Date	Material	Amount	Total	Date		Amount
3-21-61	Labor	99.75		<i>12-30-60</i>	<i>Deposit</i>	<i>200.00</i>
4-8-61	"	38.28	138.03	<i>5-26-61</i>	<i>Paid</i>	<i>25.70</i>
	10% O.H.	13.80	151.83			<i>225.70</i>
	62' 6" Transite pipe @.78		48.36			
	9 3/4 ton 3/4" Stone @1.50		14.61			
	1 6" 90° Transite Elbow		5.40			
	3 hrs. Town Shovel @6.50		19.50			
	3 hrs. Trucking @3.00		9.00			
	1 hr. Loader @3.00		3.00			
	24 x 3 Patch		24.00			
			275.70			

DATE _____

TOWN OF LEXINGTON — BOARD OF PUBLIC WORKS
SEWER DIVISION

Sketch of Service Here **8**

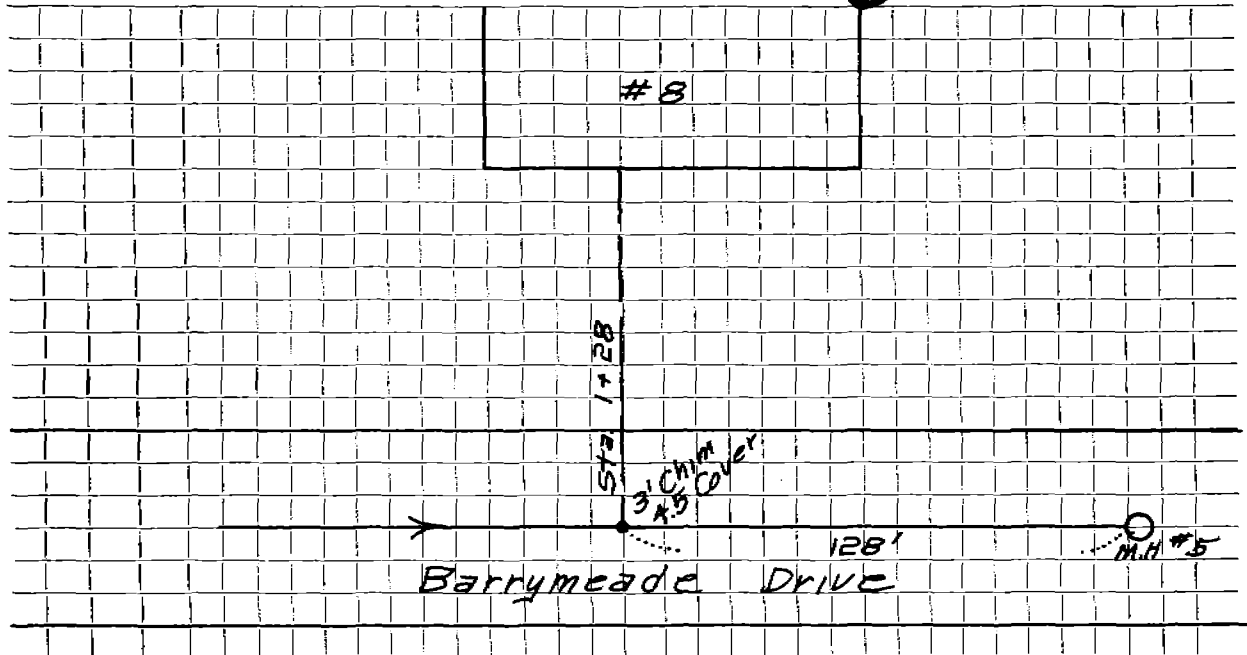

Connection made in Street. Work completed

Remarks:
.....
.....