

Name John Marshall

Service No. 98

Address 10 Bartlett Avenue

Location

Kind of Pipe

COM. 8-30-54 Size

Size of Main

Repair—Renewal—New Service

SERVICE WAS IN TO CURB:

Location

Date	Material	Amount	Total	Date	Amount
6/26/54	Labor	50 90		6-22-54	Deposited 125 00
	10% Overhead	5 09	55 99	8-30-54	Refunded (11 86
	16' - 5" Sewer Pipe @ .30		4 80		113 14
	Joint Compound		96		
	1 Hr. Town Shovel @ 5.00		5 00		
	1 Hr. Trucking		75		
			67 50		
	Plus attached card:		(45 64)		
	total charge:		113 14		
	Labor				

TOWN OF LEXINGTON—DEPT. OF PUBLIC WORKS
SEWER DIVISION

DATE

NO.


The undersigned applies for the construction of a particular sewer connecting No.
Street and hereby agrees to comply with the Rules and Regulations governing the construction and use of Particular
Sewers, as now or at any future time established by the Board of Selectmen.

Am't of estimate \$.....

Am't Paid \$.....

..... Owner

Sketch of Service Here

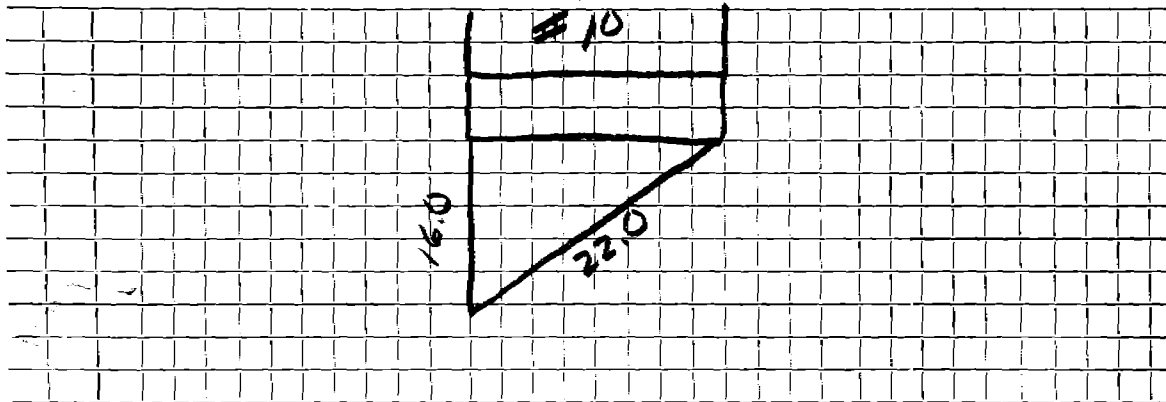

Connection made in Street.

Work completed 19..

Remarks: