

Name I. W. Stephens

Service No. 8

Address 11 Bartlett Avenue (Mail--Washington St., Arl.)

Location

Comm. 6-10-57

Kind of Pipe

Size

Size of Main

~~Repair~~ ~~Renewal~~ New Service

Location

Date	Material	Amount	Total	Date	Amount
------	----------	--------	-------	------	--------

5/1/57	Labor	33 88		2-20-57	Deposit	\$ 200 00
--------	-------	-------	--	---------	---------	-----------

5/2/57	Labor	26 58		6-10-57	Refund	44 05
--------	-------	-------	--	---------	--------	-------

	10% overhead	6.05	66 51			\$ 155 95
--	--------------	------	-------	--	--	-----------

	56' Transite Pipe @.7020		39 31			
--	--------------------------	--	-------	--	--	--

	1 Clay Elbow		1 88			
--	--------------	--	------	--	--	--

	4 Hrs. Town Shovel @6.50		26 00			
--	--------------------------	--	-------	--	--	--

	3 Hrs. Trucking @.75		2 25			
--	----------------------	--	------	--	--	--

	20 x 3 Patch		20 00			
--	--------------	--	-------	--	--	--

155 95

Labor

TOWN OF LEXINGTON—DEPT. OF PUBLIC WORKS

**SEWER DIVISION**

DATE .....

NO. ....

The undersigned applies for the construction of a particular sewer connecting No. ....  
Street and hereby agrees to comply with the Rules and Regulations governing the construction and use of Particular  
Sewers, as now or at any future time established by the Board of Selectmen.


Am't of estimate \$.....

Am't Paid \$.....

..... Owner

---

**Sketch of Service Here**

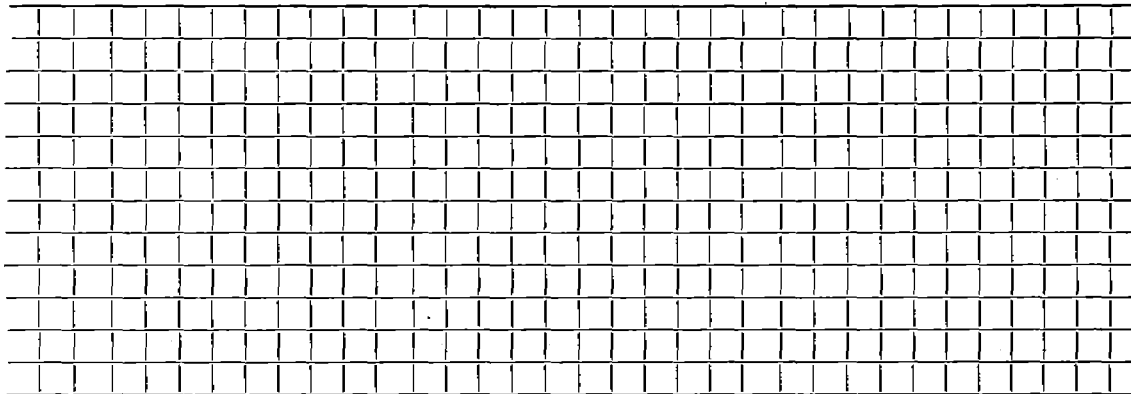

Connection made in ..... Street.

Work completed ..... 19..

Remarks: