

Name Fred Antonelli

Service No. 44

Address 16 Bartlett Avenue

Location

Kind of Pipe

Size

Size of Main

COM. 6-13-55

~~Repair~~ ~~Renewal~~ — New Service

SERVICE WAS IN TO CURE:

Location

| Date | Material | Amount | Total | Date | Amount |
|------|----------|--------|-------|------|--------|
|------|----------|--------|-------|------|--------|

|         |                                  |       |       |         |                  |
|---------|----------------------------------|-------|-------|---------|------------------|
| 4/28/55 | Labor                            | 31 81 |       | 4-12-55 | Deposited 175 00 |
|         | 10% overhead                     | 3 18  | 34 99 | 6-13-55 | Refunded (41 25) |
|         | 42' - 6" sewer pipe @ .32        |       | 13 44 |         | 133 75           |
|         | joint compound                   |       | 2 43  |         |                  |
|         | 5 hrs. Littlefield shovel @ 7.50 |       | 37 50 |         |                  |
|         | 1 hr. trucking                   |       | 75    |         |                  |
|         |                                  |       | 89 11 |         |                  |

Plus attached card: (44 64)  
 Total Charge 133 75

Labor

**TOWN OF LEXINGTON—DEPT. OF PUBLIC WORKS**  
**SEWER DIVISION**

DATE.....

NO. ....

The undersigned applies for the construction of a particular sewer connecting No.....  
Street and hereby agrees to comply with the Rules and Regulations governing the construction and use of Particular  
Sewers, as now or at any future time established by the Board of Selectmen.


Am't of estimate \$.....

Am't Paid \$.....

..... Owner

---

**Sketch of Service Here**

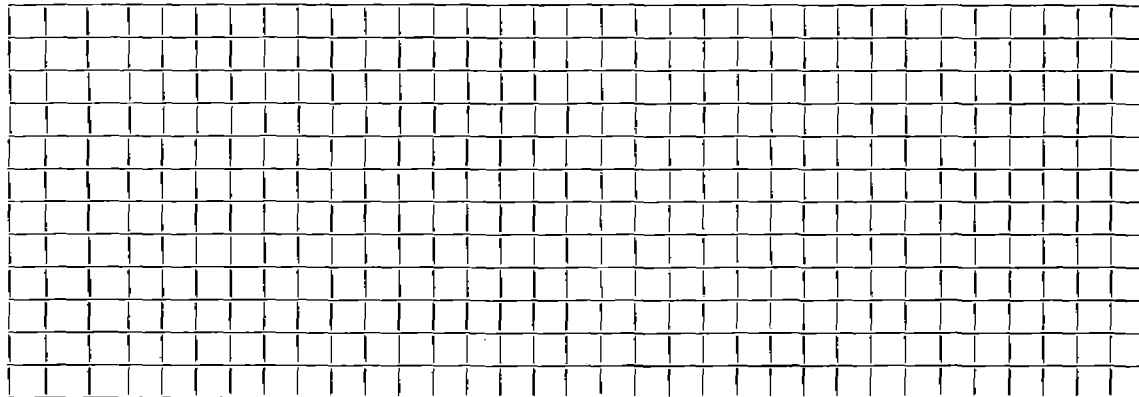

Connection made in..... Street.

Work completed.....19..

Remarks:

Name

Service No.

Address 16 Bartlett Avenue

Location

Kind of Pipe

Size

Size of Main

Repair ~~Renewal~~ New Service

Location

| Date | Material     | Amount | Total | Date                            |                   | Amount        |
|------|--------------|--------|-------|---------------------------------|-------------------|---------------|
|      |              |        |       |                                 |                   |               |
|      |              |        |       |                                 | <u>NON CHARGE</u> |               |
|      |              |        |       | 6/24/55                         | Labor             | 65 65         |
|      |              |        |       | 6/25/55                         | Labor             | 35 35         |
|      |              |        |       | 40'-6" Sewer Pipe @.32          |                   | 12 80         |
|      |              |        |       | Joint Compound                  |                   | 2 40          |
|      |              |        |       | 14hrs. Littlefield Shovel @7.50 |                   | 105. 00       |
|      |              |        |       | 4 hrs. Trucking @.75            |                   | 3. 00         |
|      |              |        |       |                                 |                   | <u>224 20</u> |
|      | <b>Labor</b> |        |       |                                 |                   |               |
|      |              |        |       |                                 |                   |               |
|      |              |        |       |                                 |                   |               |
|      |              |        |       |                                 |                   |               |

TOWN OF LEXINGTON—DEPT. OF PUBLIC WORKS  
SEWER DIVISION

DATE .....

NO. ....

The undersigned applies for the construction of a particular sewer connecting No. ....  
Street and hereby agrees to comply with the Rules and Regulations governing the construction and use of Particular  
Sewers, as now or at any future time established by the Board of Selectmen.


Am't of estimate \$.....

Am't Paid \$.....

..... Owner

#16

Sketch of Service Here

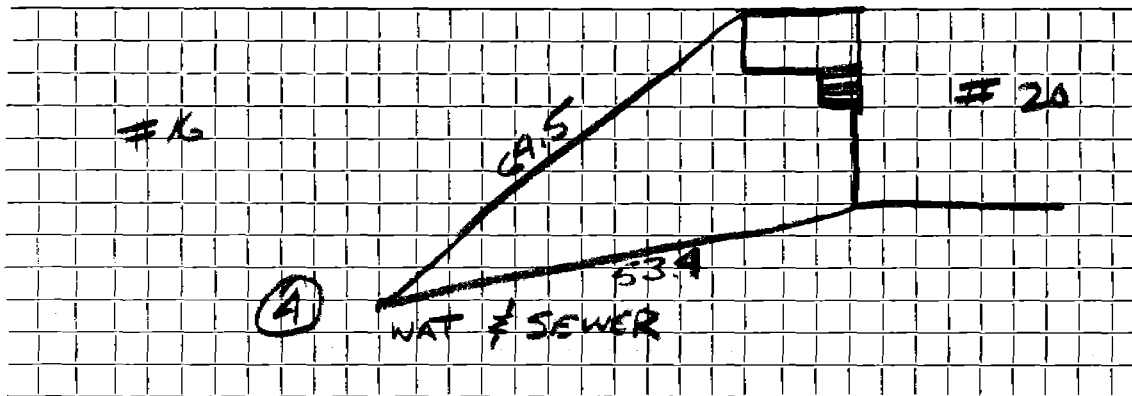

Connection made in ..... Street.

Work completed ..... 19..

Remarks:

Name

*House # 16*

Service No.

Address

Lots 158, 159, 160 & 161 Bartlett Ave.

Location

Kind of Pipe

Size

Size of Main

~~Repair~~ ~~Renewal~~ ~~New Service~~ SERVICE IN TO CURB - TO BE CHARGED WHEN

Location

CONNECTED

| Date    | Material             | Amount | Total | Date |  | Amount |
|---------|----------------------|--------|-------|------|--|--------|
| 10/2/53 | Labor                | 13 71  |       |      |  |        |
|         | 10% Overhead         | 1 37   | 15 08 |      |  |        |
|         | 16' - 6" sewer pipe  | 3.3036 | 4 85  |      |  |        |
|         | joint compound       |        | 96    |      |  |        |
|         | 2 hrs. Brox shovel   | 10.00  | 20 00 |      |  |        |
|         | 1 hr. Allis-Chalmers |        | 3 00  |      |  |        |
|         | 1 hr. trucking       |        | 75    |      |  |        |
|         |                      |        | 44 64 |      |  |        |
|         |                      |        |       |      |  |        |
|         |                      |        |       |      |  |        |
|         | <b>Labor</b>         |        |       |      |  |        |
|         |                      |        |       |      |  |        |
|         |                      |        |       |      |  |        |
