




DATE \_\_\_\_\_

TOWN OF LEXINGTON — BOARD OF PUBLIC WORKS  
SEWER DIVISION

Sketch of Service Here

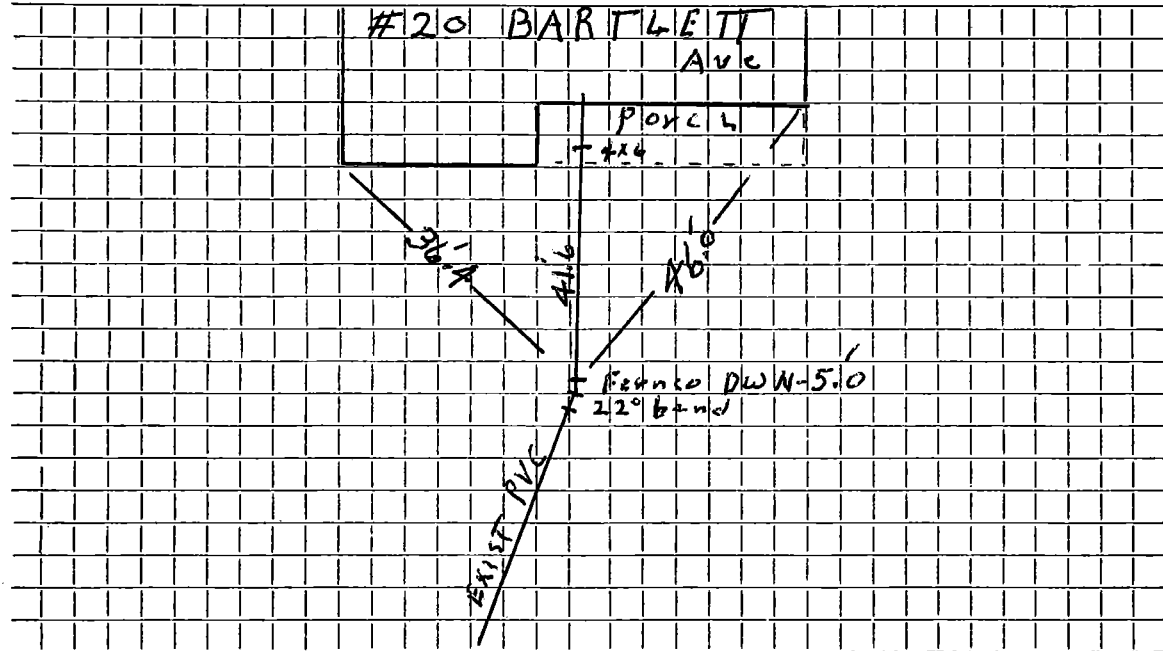

Connection made in ..... Street. Work completed 6/17/10 .....

Remarks: SEWER MAIN 1995 - SENESETT .....

.....  
.....