

Name Francis H. Lawless, Jr.

Service No. 86

Address 21 Bartlett Avenue

Location

Kind of Pipe

COM. 8-30-54 ^{Size}

Size of Main

Repair ~~Renewal~~ — New Service

SERVICE WAS IN TO CURB:

Location

Date	Material	Amount	Total	Date	Amount
------	----------	--------	-------	------	--------

6/26/54	Labor	71 05		6-3-54 Deposited	125 00
	10% Overhead	<u>7 11</u>	78 16	8-30-54 Refunded	<u>(26 21)</u>
	32'-6" Sewer Pipe .30		9 60		148 79
	1-6"-1/8 Bend		1 24		
	Joint Compound		1 92		
	2 Hrs. Town Scoop @ 5.00		10 00		
	2 Hrs. Trucking @ .75		<u>1 50</u>		
			102 42		
	Plus attached card		<u>(46 37)</u>		
			148 79		

Labor

TOWN OF LEXINGTON—DEPT. OF PUBLIC WORKS
SEWER DIVISION

DATE.....

NO. ...86.....


The undersigned applies for the construction of a particular sewer connecting No.....
Street and hereby agrees to comply with the Rules and Regulations governing the construction and use of Particular
Sewers, as now or at any future time established by the Board of Selectmen.

Am't of estimate \$.....

Am't Paid \$.....

..... Owner

Sketch of Service Here

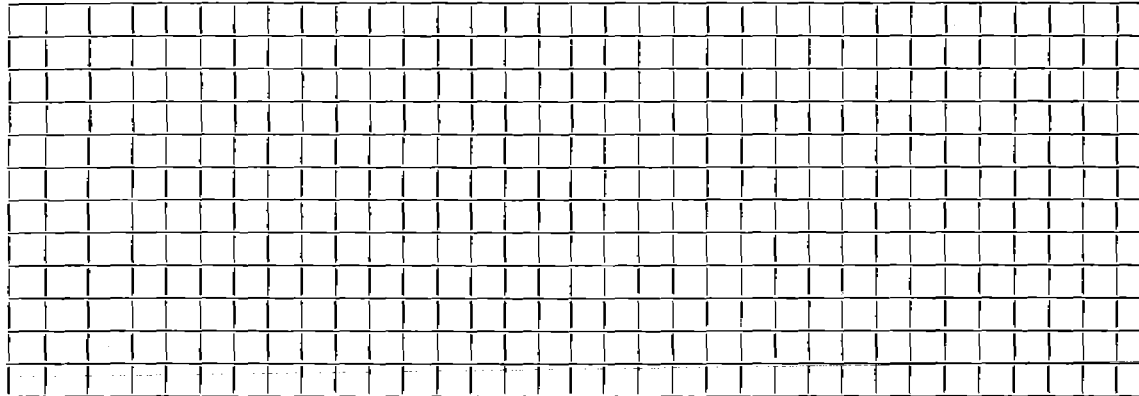

Connection made in..... Street.

Work completed.....19..

Remarks:

Name

Service No.

Address

21 Bartlett Avenue

Location

Kind of Pipe

Size

Size of Main

Repair ~~Renewal~~ — New Service SERVICE IN TO CURB - TO BE CHARGED WHEN CONNECTED

Location

Date	Material	Amount	Total	Date	Amount
10/5/53	Labor	11 97			
	10% Overhead	1 20	13 17		
	26- 6" sewer pipe	①.3036	7 89		
	joint compound		1 56		
	2 hrs. Brox shovel	@10.00	20 00		
	1 hr. Allis-Chalmers		3 00		
	1 hr. trucking		75		
			46 37		
	Labor				

TOWN OF LEXINGTON—DEPT. OF PUBLIC WORKS
SEWER DIVISION

DATE

NO.


The undersigned applies for the construction of a particular sewer connecting No.
Street and hereby agrees to comply with the Rules and Regulations governing the construction and use of Particular
Sewers, as now or at any future time established by the Board of Selectmen.

Am't of estimate \$.

Am't Paid \$.

..... Owner

Sketch of Service Here

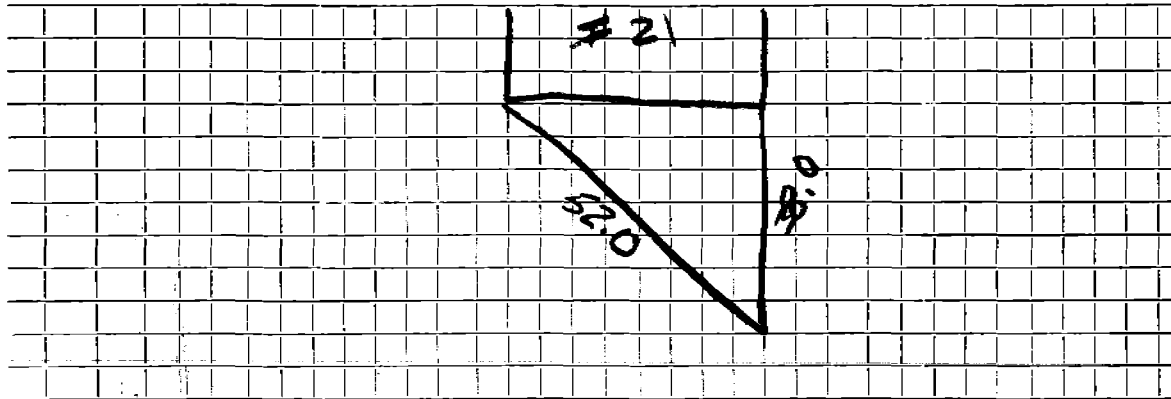

Connection made in Street.

Work completed 19..

Remarks: