

Name Carl Wirpio

Service No. 50

Address 22 Bartlett Avenue

Location

Kind of Pipe

Size

Size of Main

Repair—Renewal—New Service Valeri #618 *W/O # 4715*

Location JAN 22 1968

Date		Material	Amount	Total	Date	Amount
6-8-67	35'	6" Transite pipe			5-26-67	150 00
		4" Cast Iron			5-23-68	37 74
						187 74
6/7/67		Labor	58.48			
7/5/67		"	10.05			
7/5/67		"	13.49			
7/6/67		"	10.05	92 07		
		10% O.H.	9 21	101 28		
	20'	6" Transite pipe @.88		17 60		
	1	22½" Sweep		2 35		
	½	Bag Cement @ 1.55		78		
	2½	Ton ¾" Stone @ 1.65		4 13		
	2	Ton cold patch @ 5.00		10 00		
	2	Ton hot top @ 5.80		11 60		
	8	Hrs. Trucking @ 3.00		24 00		
	2	Hrs. Shovel @ 6.50		13 00		
	1	Hr. Roller @ 3.00		3 00		
				187 74		


*Deposit*  
*Paid*

*Bill - 1-27-68*

DATE \_\_\_\_\_

TOWN OF LEXINGTON — BOARD OF PUBLIC WORKS  
SEWER DIVISION

Sketch of Service Here

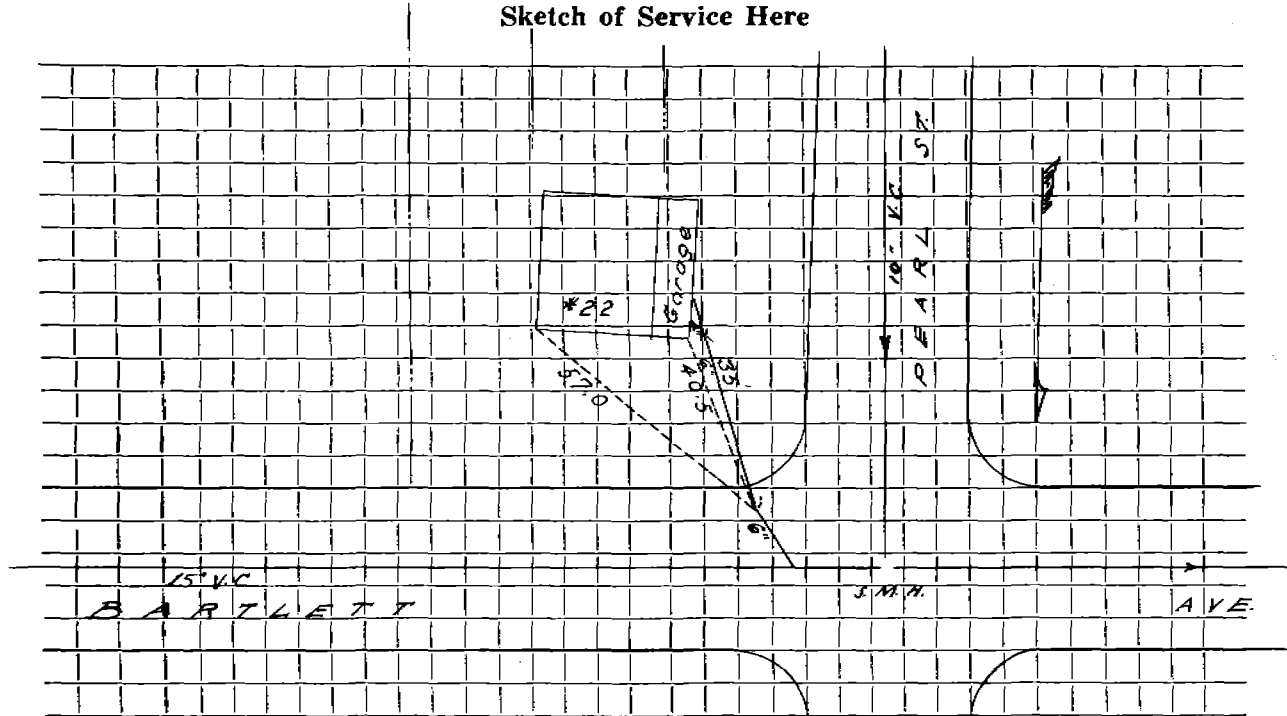

Connection made in ..... Street. Work completed .....

Remarks: *Service from Pearl St*

.....  
.....



**TOWN OF LEXINGTON—DEPT. OF PUBLIC WORKS**  
**SEWER DIVISION**

DATE .....

NO. ....


The undersigned applies for the construction of a particular sewer connecting No. ....  
Street and hereby agrees to comply with the Rules and Regulations governing the construction and use of Particular  
Sewers, as now or at any future time established by the Board of Selectmen.

Am't of estimate \$. ....

Am't Paid \$. ....

..... Owner

**Sketch of Service Here**

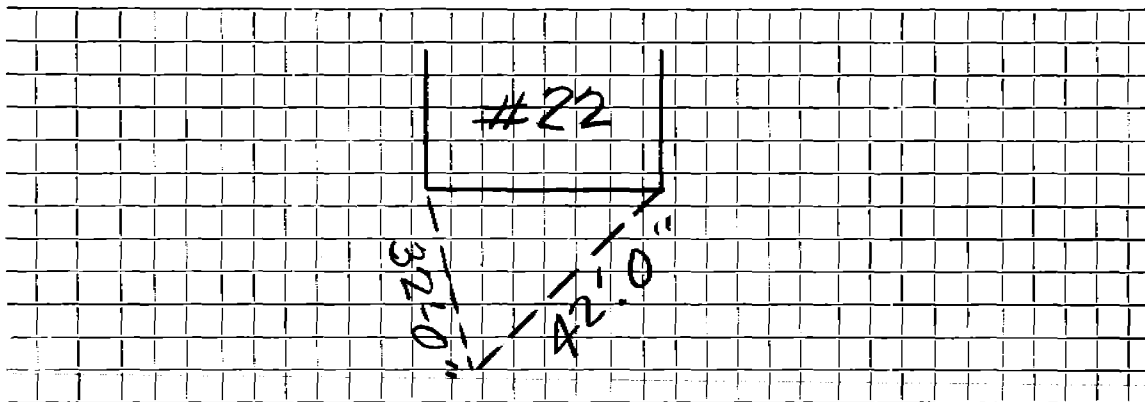

Connection made in ..... Street.

Work completed ..... 19..

Remarks: