

Name Andrew Southerland

Service No. 196

Address 31 Bartlett Ave.

Location

Kind of Pipe *WO # 7734* Size Size of Main

~~Repair-Renewal~~ ~~New Service~~ SERVICE IN TO CURB-TO BE CHARGED WHEN CONNECTED Location *Conn 12-10-62*

Date	Material	Amount	Total	Date	Amount
10/1/53	Labor	24 86		11-15-62	Deposit 200 00
	10% Overhead	2 49	27 35	12-16-62	Refund 81 69
	20' - 6" sewer pipe @.3036		6 07		118 31
	joint compound		1 20		
	8 hrs. Brox shovel @10.00		20 00		
	1 hr. Allis-Chalmers		3 00		
	1 hr. trucking		75		
			58 37		
11-21-62	Labor	23.49			
	10% O.H.	2.35	25.84		
	30' 6" Transite pipe @82		24.60		
	1 Hr. Town Shovel @6.50		6.50		
	1 Labor Trucking @3.00		3.00		
			118.31		

TOWN OF LEXINGTON—DEPT. OF PUBLIC WORKS  
**SEWER DIVISION**

DATE .....

NO. ....


The undersigned applies for the construction of a particular sewer connecting No. ....  
Street and hereby agrees to comply with the Rules and Regulations governing the construction and use of Particular  
Sewers, as now or at any future time established by the Board of Selectmen.

Am't of estimate \$. ....

Am't Paid \$. ....

..... Owner

Sketch of Service Here

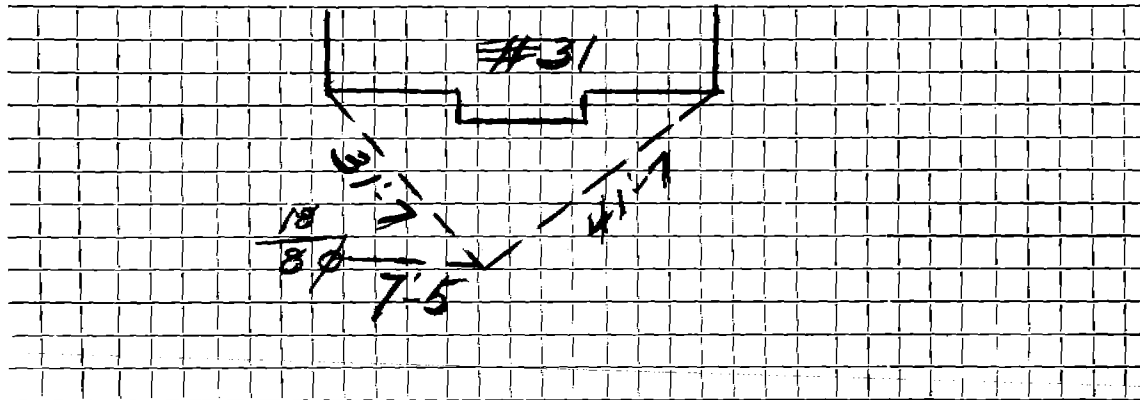

Connection made in ..... Street.

Work completed ..... 19..

Remarks: