

Name N.Y. Brother's Trust

Service No. 38

Address 32 Bartlette Ave.

Location

Kind of Pipe

Size

Size of Main

Repair—Renewal—New Service WO #4574

Location AUG 16 1976


Date	Material	Amount	Total	Date	Amount
6/8/76	labor	50. 48		6-8-76	125. 00
	10%OH	5. 05	55. 53	8-16-76	14. 59
2	10' X 6" Transite Pipe @ 1.48		29. 60		
1	End Cap-6"		3. 75		
½	Bag Cement		. 81		
8	Red Bricks @.12		. 96		
½	Ton Cold Patch		3. 44		
1	hr. truck		3. 00		
1	hr. shovel		6. 50		
	Street 8' X 15' long		79. 98		
			183. 57		

Repair
Paid by WHP #19
paid by [unclear]

DATE _____

TOWN OF LEXINGTON — BOARD OF PUBLIC WORKS
SEWER DIVISION

Sketch of Service Here

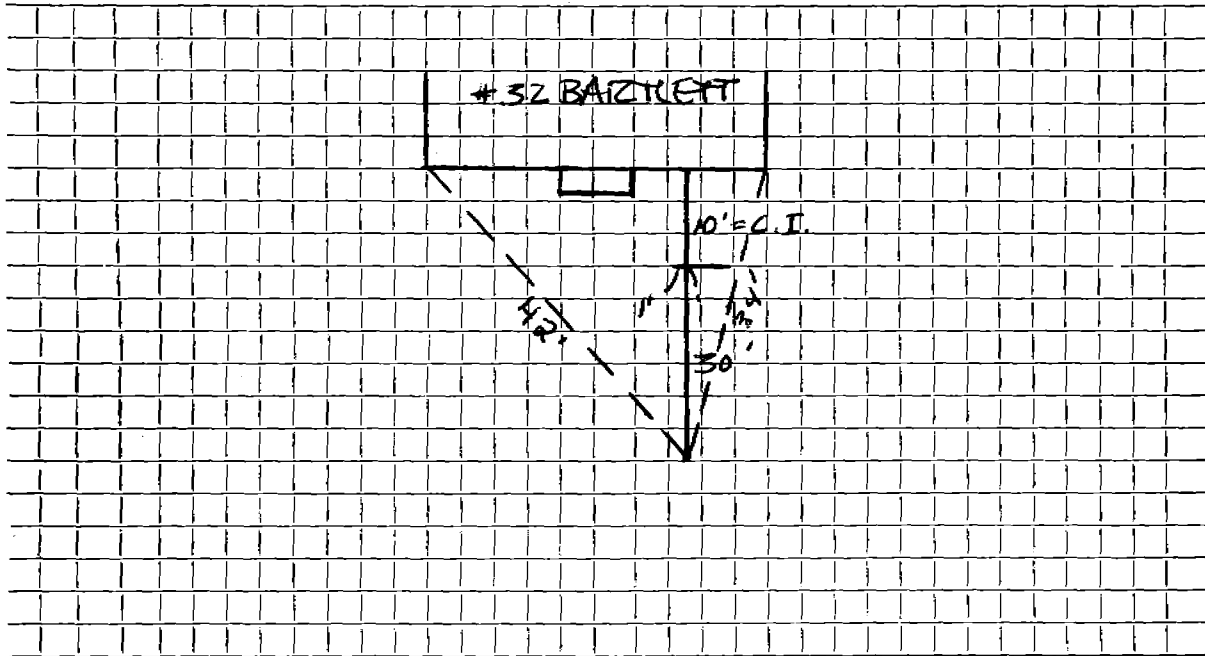

Connection made in .32. BARTLETT. AVE... Street. Work completed ... 6/18/76.....

Remarks:
.....
.....