

Name Robert Wilson

Service No. 48

Address 33 Bartlett Avenue

Location

Kind of Pipe

Size

Size of Main

~~Repair-Renewal~~ ~~New Service~~ SERVICE IN TO CURB-TO BE CHANGED WHEN  
Surianello #2516 & CONNECTED

Location AUG 16 1976

Date	Material	Amount	Total	Date	Amount
10/1/53	Labor	24 86		2/17/74	58 37
	10% Overhead	2 49	27 35	Deposit	
	20' - 6" sewer pipe @ .3036		6 07		
	joint compound		1 20		
	2 hrs. Brox shovel @10.00		20 00		
	1 hr. Allis- Chalmers		3 00		
	1 hr. trucking		75		
			58 37		
7/22/74	80' 6" Transite Pipe				
(inside)	24' 4" Cast Iron Pipe				
	Labor				

TOWN OF LEXINGTON—DEPT. OF PUBLIC WORKS

SEWER DIVISION

DATE .....

NO. ....


The undersigned applies for the construction of a particular sewer connecting No. .... Street and hereby agrees to comply with the Rules and Regulations governing the construction and use of Particular Sewers, as now or at any future time established by the Board of Selectmen.

Am't of estimate \$.....

Am't Paid \$.....

..... Owner

Sketch of Service Here

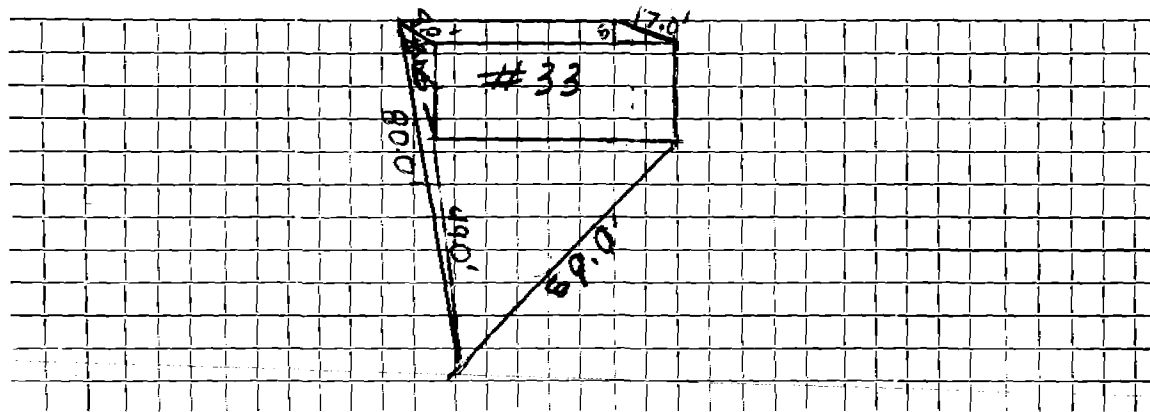

Connection made in #33 Bartlett Ave. Street.

Work completed 7/22/74 19..

Remarks: