

Name Mary Byrne

Service No. 45

Address 35 Bartlett Avenue

Eagle #1879

Location

JUN 5 1972

Kind of Pipe

Size

Size of Main


~~Repair~~ ~~Reconnect~~ New Service SERVICE IN TO CURB: TO BE CHARGED WHEN CONNECTED Location

Date	Material	Amount	Total	Date	Amount
9/30/53	Labor	16 71		6-24-71	Deposit
	10% overhead	1 67	18 38		49 40
	20' - 6" sewer pipe @.3036		6.07		
	Joint compound		1.20		
	2 hrs. Brox Shovel @ 10.00		20.00		
	1 hr. Allis-Chalmers		3.00		
	1 hr. trucking		.75		
			49.40		
6/28/71	50' 6" Transite pipe				

DATE \_\_\_\_\_

TOWN OF LEXINGTON — BOARD OF PUBLIC WORKS  
SEWER DIVISION

Sketch of Service Here

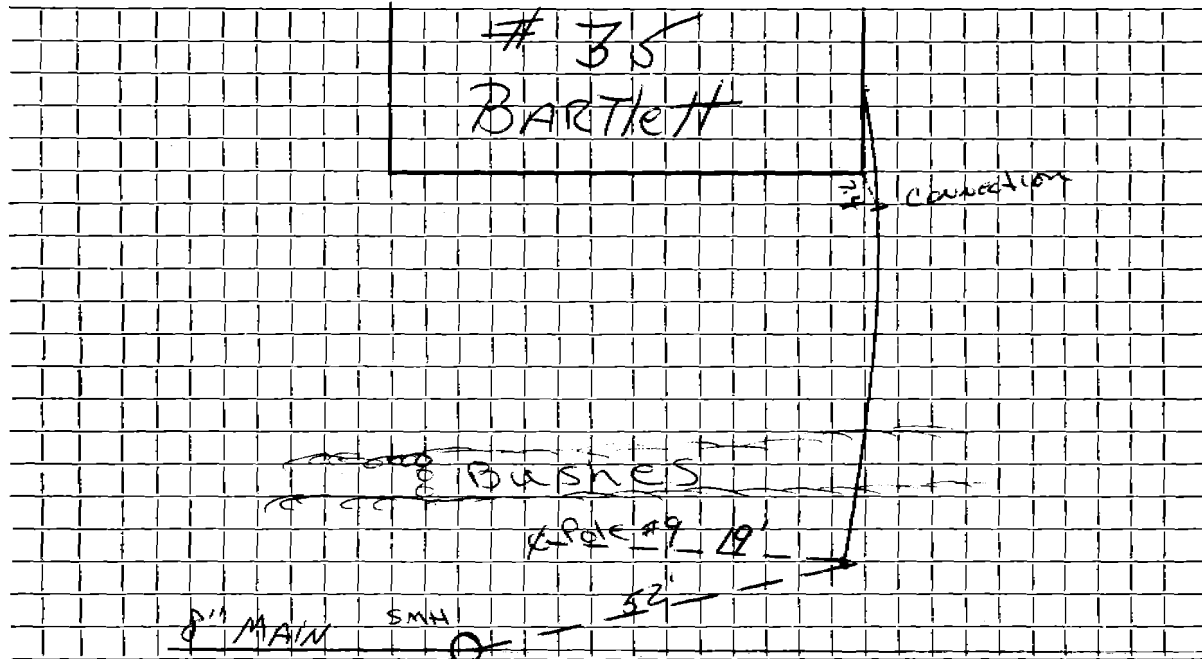

Connection made in ..... Street. Work completed .....

Remarks: .....  
.....  
.....