

Name Richard Hamilton

Service No. 217

Address 36 Bartlett Avenue

Lot #119 & #120

Location

Kind of Pipe

Size

Size of Main

~~Repair~~ ~~Renewal~~ New Service

Location *Comm 12-31-59*


Date	Material	Amount	Total	Date	Amount
	PREVIOUS CHARGE ON OTHER CARD		58.38	<i>11-28-59</i>	<i>Deposit</i> 200.00
11-6-59	Labor	12.40		<i>12-31-59</i>	<i>Retard</i> 88.53
	10% O.H.	1.24	13.64		111.47
	48' 6" Transite pipe @.70		33.60		
	1 11 $\frac{1}{2}$ " Transite Bend		5.10		
	1 hr. Trucking @.75		.75		
			111.47		

DATE _____

TOWN OF LEXINGTON — BOARD OF PUBLIC WORKS

SEWER DIVISION

Sketch of Service Here

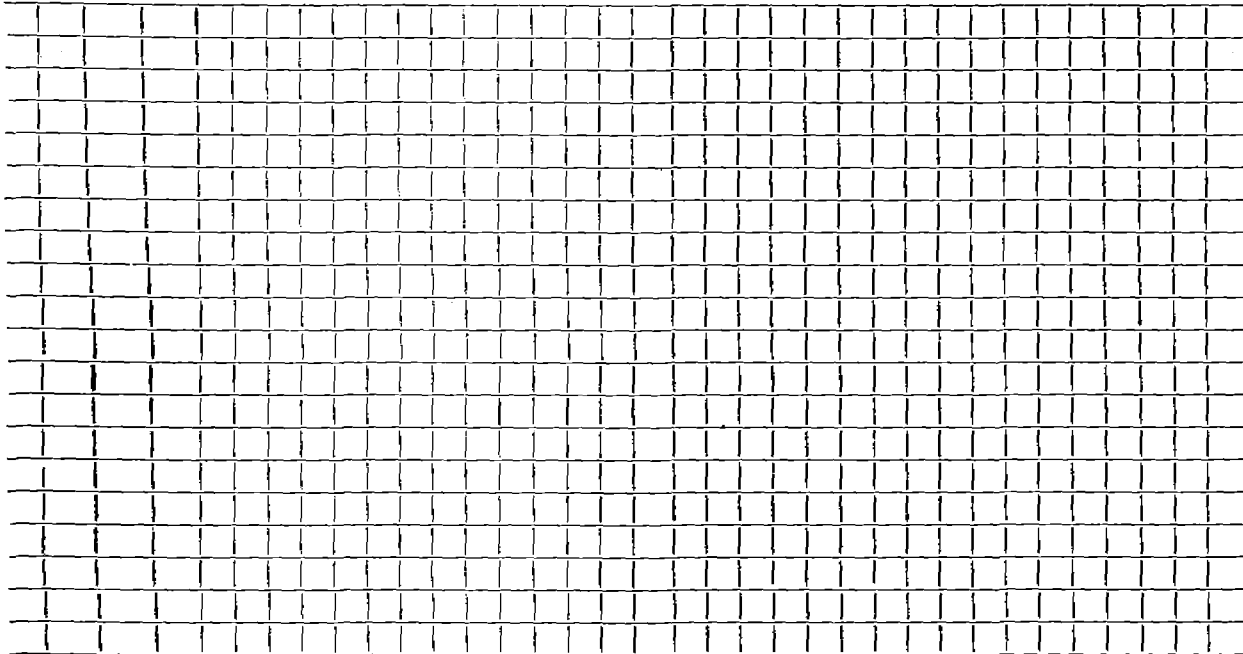

Connection made in Street. Work completed

Remarks:
.....
.....

TOWN OF LEXINGTON—DEPT. OF PUBLIC WORKS
SEWER DIVISION

DATE

NO.


The undersigned applies for the construction of a particular sewer connecting No.
Street and hereby agrees to comply with the Rules and Regulations governing the construction and use of Particular
Sewers, as now or at any future time established by the Board of Selectmen.

Am't of estimate \$.....

Am't Paid \$.....

..... Owner

Sketch of Service Here

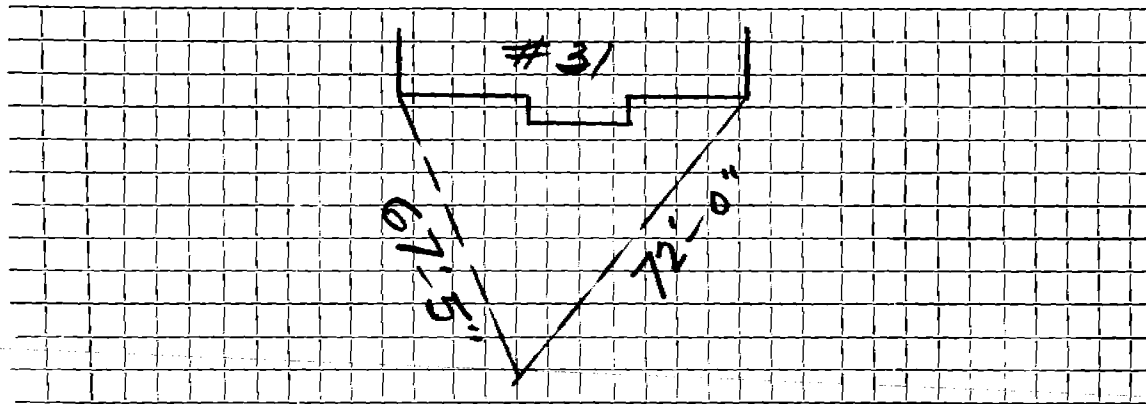

Connection made in Street.

Work completed 19..

Remarks: