

Name Richard Hamilton

Service No. 219

Address 40 Bartlett Avenue

Lot #115 & #116

Location

Kind of Pipe

Size

Size of Main

~~Repair~~ ~~Renewal~~ ~~New Service~~


Location *Comm 12-31-59*

Date	Material	Amount	Total	Date	Amount
11-	PREVIOUS CHARGE ON OTHER CARD		49.40	<i>11-28-59</i>	<i>Deposit 200.00</i>
11-6-59	Labor	12.40		<i>12-31-59</i>	<i>Deposit Returned 97.51</i>
	10% O.H.	1.24	13.64		<i>102.49</i>
	48' 6" Transite pipe @.70		33.60		
	1 11 ¹ / ₄ " Transite Bend		5.10		
	1 hr. Trucking @.75		.75		
			102.49		

DATE _____

TOWN OF LEXINGTON — BOARD OF PUBLIC WORKS
SEWER DIVISION

Sketch of Service Here

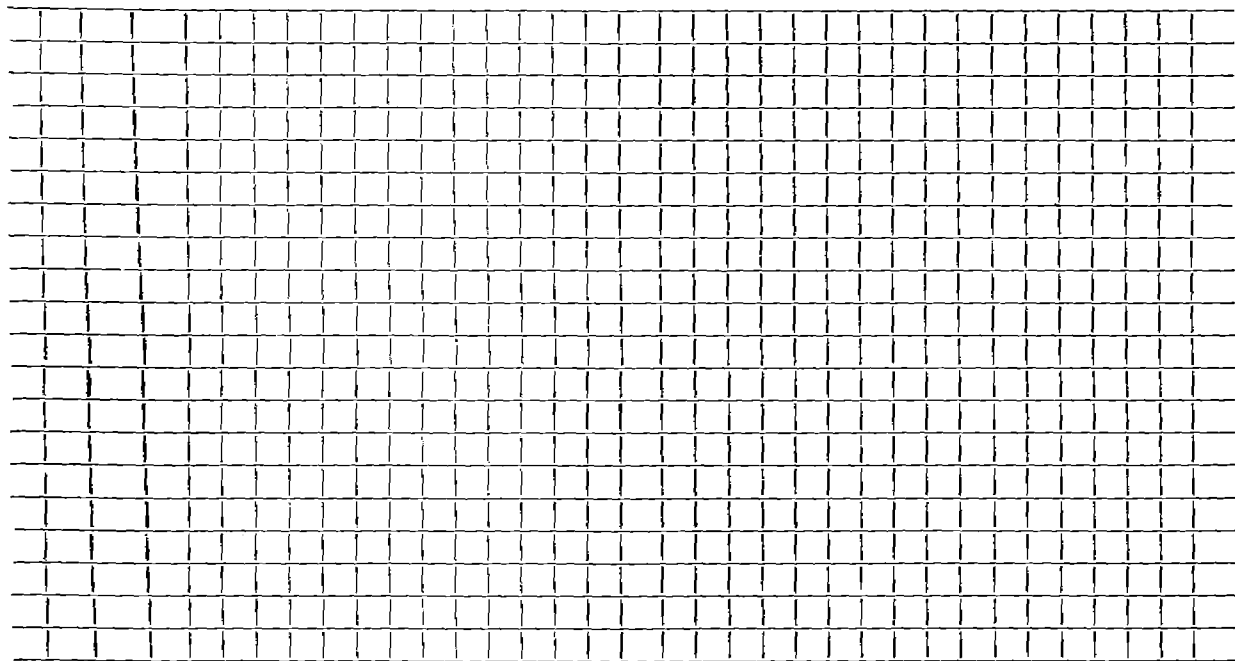

Connection made in Street. Work completed

Remarks:
.....
.....

TOWN OF LEXINGTON—DEPT. OF PUBLIC WORKS
SEWER DIVISION

DATE

NO.

The undersigned applies for the construction of a particular sewer connecting No.
Street and hereby agrees to comply with the Rules and Regulations governing the construction and use of Particular
Sewers, as now or at any future time established by the Board of Selectmen.


Am't of estimate \$.....

Am't Paid \$.....

..... Owner

#40

Sketch of Service Here

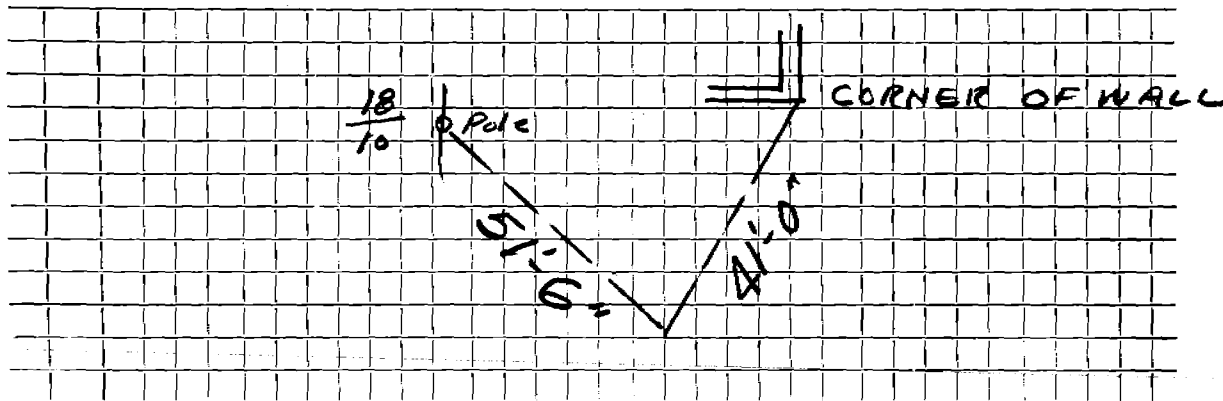

Connection made in Street.

Work completed 19..

Remarks: