

Name **Mary deMontigny**

Service No. **1**

Address **41 Bartlett Avenue**

Location

Kind of Pipe **WC# 2786**

Size

Size of Main

~~Repair~~ ~~Renewal~~ ~~New Service~~ **SERVICE IN TO CURB-TO BE CHANGED WHEN CONNECTED**

Location

Comm 6-3-63

Date	Material	Amount	Total	Date	Amount
9/30/53	Labor	16 82		1-4-63	250 00
	10% Overhead	1 63	18 50	3-10-64	32 79
	20' - 6" sewer pipe @.3036		6 07		282 79
	joint compound		1 20		
	2 hrs. Brox Shovel @10.00		20 00		
	1 hr. Allis Chalmers		3 00		
	1 hr. trucking		75		
1-8-63	Labor	104.42	49 52		
4-29-63	"	42.84	147.26		
	10% O.H.	14.73	161.99		
	39' 6" Transite pipe @.82		31.98		
	8 ton Bank Gravel @1.10		8.80		
	3 hrs. ^{Labor} Town Shovel @6.50		19.50		
	2 hrs. Trucking @3.00		6.00		
	1 hr. Loader @5.00		5.00		
			282.79		

TOWN OF LEXINGTON—DEPT. OF PUBLIC WORKS
SEWER DIVISION

DATE

NO.


The undersigned applies for the construction of a particular sewer connecting No.
Street and hereby agrees to comply with the Rules and Regulations governing the construction and use of Particular
Sewers, as now or at any future time established by the Board of Selectmen.

Am't of estimate \$.....

Am't Paid \$.....

..... Owner

Sketch of Service Here

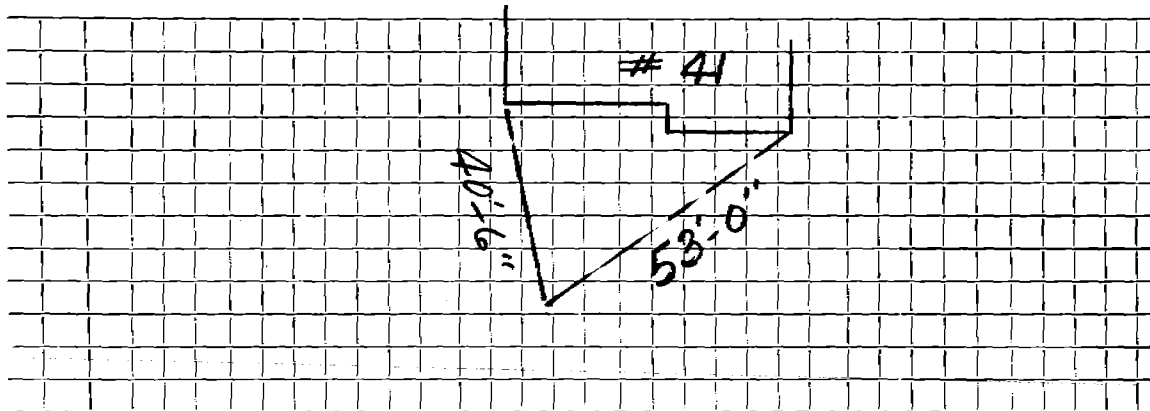

Connection made in Street.

Work completed 19..

Remarks: