

Name Joseph J. LeLievre

Service No. 220

Address 42 Bartlett Avenue

Lot #113 & #114

Location

Kind of Pipe

Size

Size of Main

~~Repair~~ ~~Renewal~~ - New Service

Location

Comp 12-31-59

Date	Material	Amount	Total	Date		Amount
	PREVIOUS CHARGE ON OTHER CARD		49.40	<i>11-28-59</i>	<i>Deposit</i>	<i>200 00</i>
11-19-59	Labor	24.11		<i>12-31-59</i>	<i>Retund</i>	<i>-60 25</i>
	10% O.H.	2.41	26.52			<i>1.59 77</i>
	48' 6" Transite pipe @.70		33.60			
	6 1/2 ton 3/4" Stone @1.50		9.75			
	2 hrs. Town Shovel @6.50		13.00			
	2 hrs. Trucking @.75		1.50			
	1 hr. Rogers Trailer @3.00		3.00			
	1 hr. Trucking @3.00		3.00			
			<u>139.77</u>			

DATE _____

TOWN OF LEXINGTON — BOARD OF PUBLIC WORKS

SEWER DIVISION

Sketch of Service Here

A large rectangular area filled with a grid of small squares, intended for drawing a sketch of sewer service. The grid consists of approximately 20 columns and 20 rows of squares.

Connection made in Street. Work completed

Remarks:

.....

.....

TOWN OF LEXINGTON—DEPT. OF PUBLIC WORKS
SEWER DIVISION

DATE

NO.

The undersigned applies for the construction of a particular sewer connecting No.
Street and hereby agrees to comply with the Rules and Regulations governing the construction and use of Particular
Sewers, as now or at any future time established by the Board of Selectmen.


Am't of estimate \$.....

Am't Paid \$.....

..... Owner

42 BARREST

Sketch of Service Here

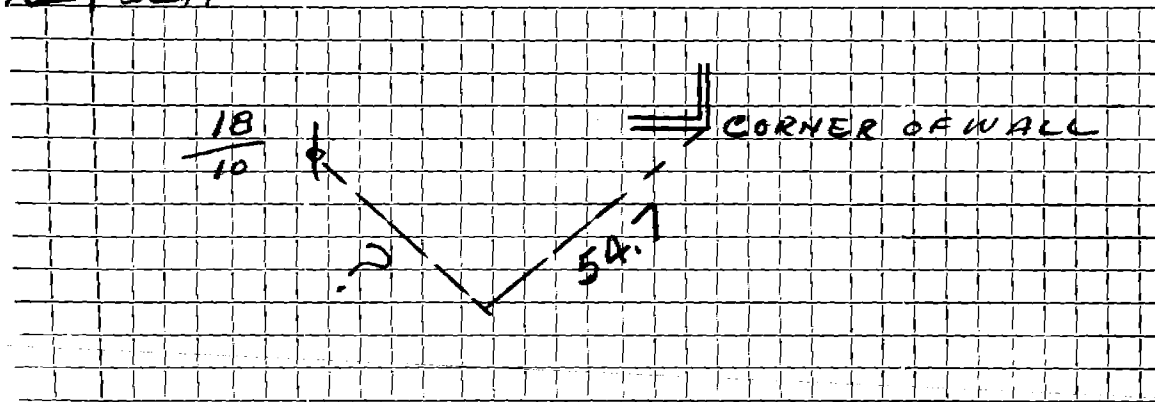

Connection made in Street.

Work completed 19..

Remarks: