

Name Joseph LeLievre

Service No. 221

Address 144 Bartlett Avenue

Location

Kind of Pipe

Size

Size of Main

~~Repair - Renewal~~ New Service


Location *Comm 2-8-59*

Date	Material	Amount	Total	Date	Amount
11-19-59	Labor	40 14		11-28-59	202 00
11-20-59	"	78 52		2-8-60	9 27
		118 66			209 27
	10% O. H.	11 87	130 53		
	60' 6" Transite pipe @.70		42 00		
	13 Ton 3/4" Stone @1.50		19 50		
	1 1 1/2" Transite Elbow		2 24		
	15 x 3 Patch		15 00		
			209 27		

DATE _____

TOWN OF LEXINGTON — BOARD OF PUBLIC WORKS
SEWER DIVISION

Sketch of Service Here

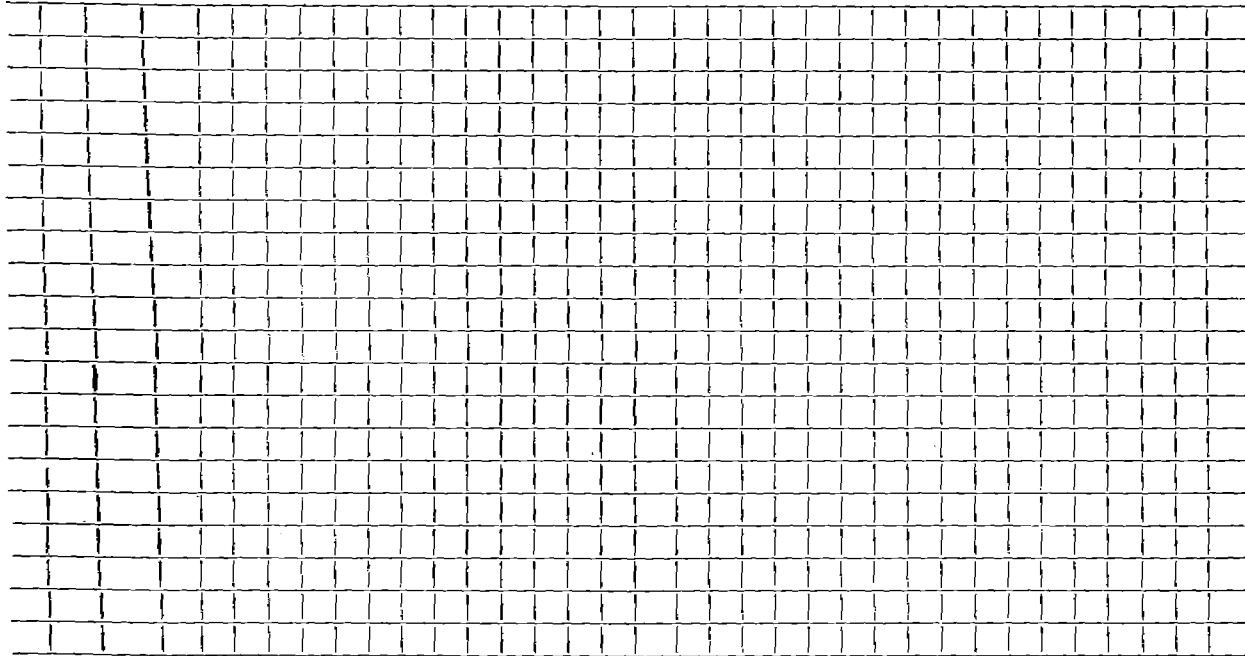A large grid of graph paper, consisting of approximately 20 columns and 25 rows of small squares, intended for sketching sewer service details.

Connection made in Street. Work completed

Remarks:
.....
.....

TOWN OF LEXINGTON—DEPT. OF PUBLIC WORKS
SEWER DIVISION

DATE

NO.

The undersigned applies for the construction of a particular sewer connecting No.
Street and hereby agrees to comply with the Rules and Regulations governing the construction and use of Particular
Sewers, as now or at any future time established by the Board of Selectmen.


Am't of estimate \$.....

Am't Paid \$.....

..... Owner

44 BARTLETT AVE.

Sketch of Service Here

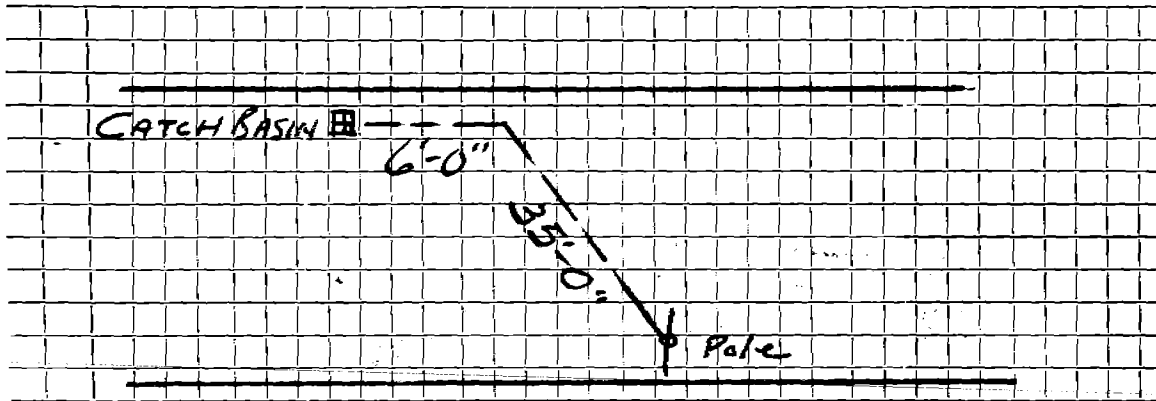

Connection made in Street.

Work completed 19..

Remarks: