

Name CHRISTIAN HIGH SCHOOL

Service No.

Address 48 lots 107 & 108<sup>a 107</sup> Bartlett Avenue

Location

Kind of Pipe

Size

Size of Main

~~Repair~~ ~~Renewal~~ ~~New Service~~ SERVICE IN TO CURB\*TO BE CHARGED WHEN CONNECTED

Location

Date	Material	Amount	Total	Date	Amount
9/29/53	Labor	28 58			
	10% Overhead	2 86	31 44		
	26' - 6" sewer pipe @.3036		7 89		
	Joint compound		1 56		
	2 hrs. Brox shovel @10.00		20 00		
	1 hr. Allis-Chalmers		3 00		
	1 hr. trucking		75		
			<u>64 64</u>		

**THIS Sewer Service  
Labor not in use 10-7-65**

**SEE NEXT CARD - ATTACHED**

TOWN OF LEXINGTON—DEPT. OF PUBLIC WORKS  
SEWER DIVISION

DATE .....

NO. ....


The undersigned applies for the construction of a particular sewer connecting No. ....  
Street and hereby agrees to comply with the Rules and Regulations governing the construction and use of Particular  
Sewers, as now or at any future time established by the Board of Selectmen.

Am't of estimate \$ . . . . .

Am't Paid \$ . . . . .

..... Owner

Sketch of Service Here

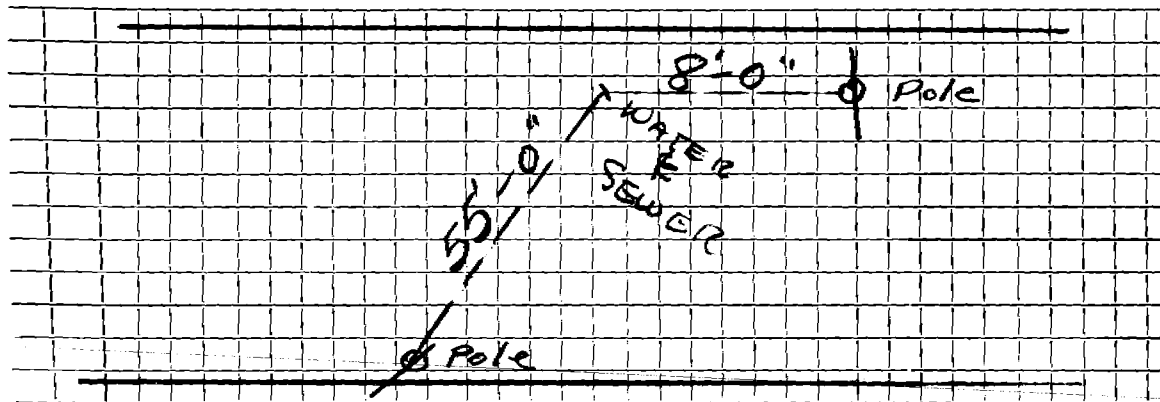

Connection made in ..... Street.

Work completed ..... 19..

Remarks:

Name Lexington Christian Academy

Service No. \_\_\_\_\_

Address 48 Bartlett Avenue

Location \_\_\_\_\_

Kind of Pipe \_\_\_\_\_

Size \_\_\_\_\_

Size of Main \_\_\_\_\_

~~Repair or Renewal~~ **New Service** Kirkland #4302


Location \_\_\_\_\_

Date	Material	Amount	Total	Date	Amount
11/29/85	58' 6" PVC				
	2' 4" PVC				
	4" x 6" Fernco				
	3" x 4" Fernco				
	6" Tee Cleanout in M.H.				
				1-27-88	S.B. Papers & Tools
				4-28-94	Release & Papers

DATE \_\_\_\_\_

TOWN OF LEXINGTON — BOARD OF PUBLIC WORKS  
SEWER DIVISION

Sketch of Service Here

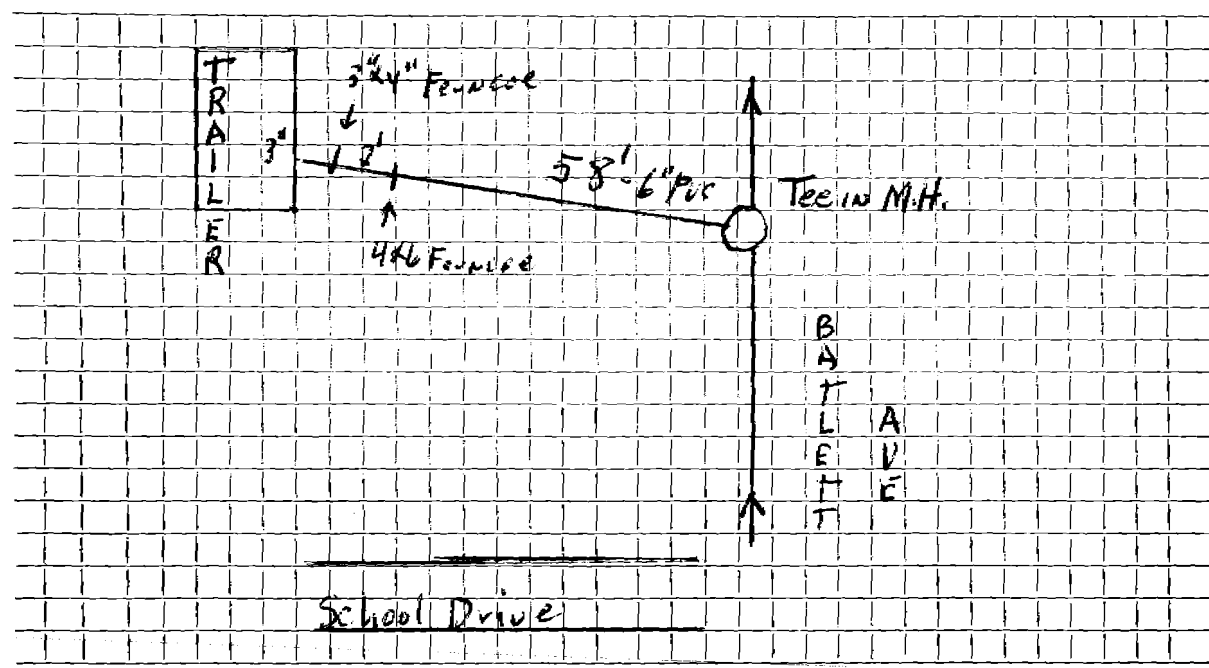

Connection made in ..... Street. Work completed .....

Remarks: .....  
.....  
.....

Name Christen High School

Service No.

Address 48 Bartlett Avenue

Location

Kind of Pipe

Size

Size of Main

Repair—Renewal—New Service

Permit #199  
Scott Prescott


Location

Date	Material	Amount	Total	Date	Amount
2/16/65	470.5' 8" Transite pipe				
	everything installed by contractor				
<p>↑ New Service to School 10-7-65</p>					

DATE \_\_\_\_\_

TOWN OF LEXINGTON — BOARD OF PUBLIC WORKS  
SEWER DIVISION

Sketch of Service Here

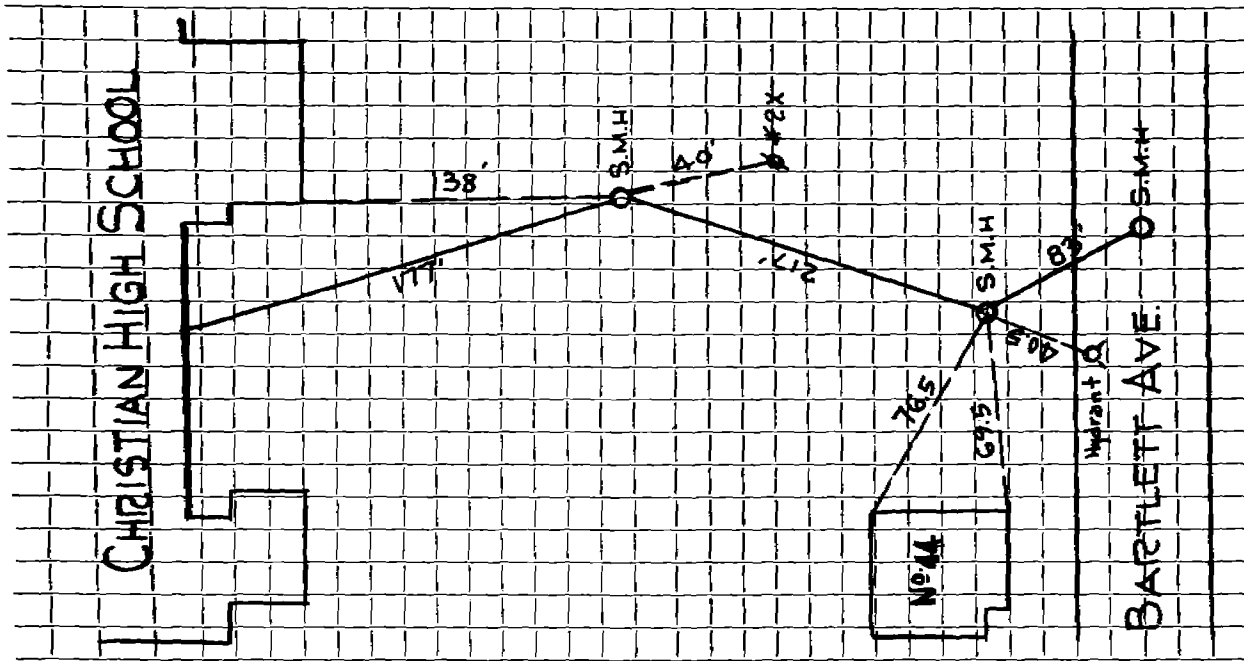

Connection made in \_\_\_\_\_ Street. Work completed \_\_\_\_\_  
marks: \_\_\_\_\_  
\_\_\_\_\_