

Name Carol Batstone

Service No. 31

Address 49 Bartlett Avenue

Location

Kind of Pipe

Size

Size of Main

~~Repair-Renewal~~ New Service Baptiste 3996


Location OCT 21 1985

Date	Material	Amount	Total	Date	Amount		
9/29/53	Labor	19.98		9-17-85 Deposit	53.00		
	10% O.H.	2.00	\$21.98				
20'	6" Clay Sewer Pipe @.3036		6.07				
	Joint Compound		1.20				
2	hrs. Brox Shovel @ \$10.00		20.00				
1	hr. Allis-Chalmers @ \$3.00		3.00				
1	hr. Trucking @.75		.75				
			\$53.00				
9/26/85	67' 6" PVC						
	10' 4" PVC						
	1 22° Bend						
	1 45° Bend						
	1 4" x 6" Fernco						
	1 6" Clay to PVC Fernco						
	1 6" Coup.						

DATE _____

TOWN OF LEXINGTON — BOARD OF PUBLIC WORKS
SEWER DIVISION

Sketch of Service Here

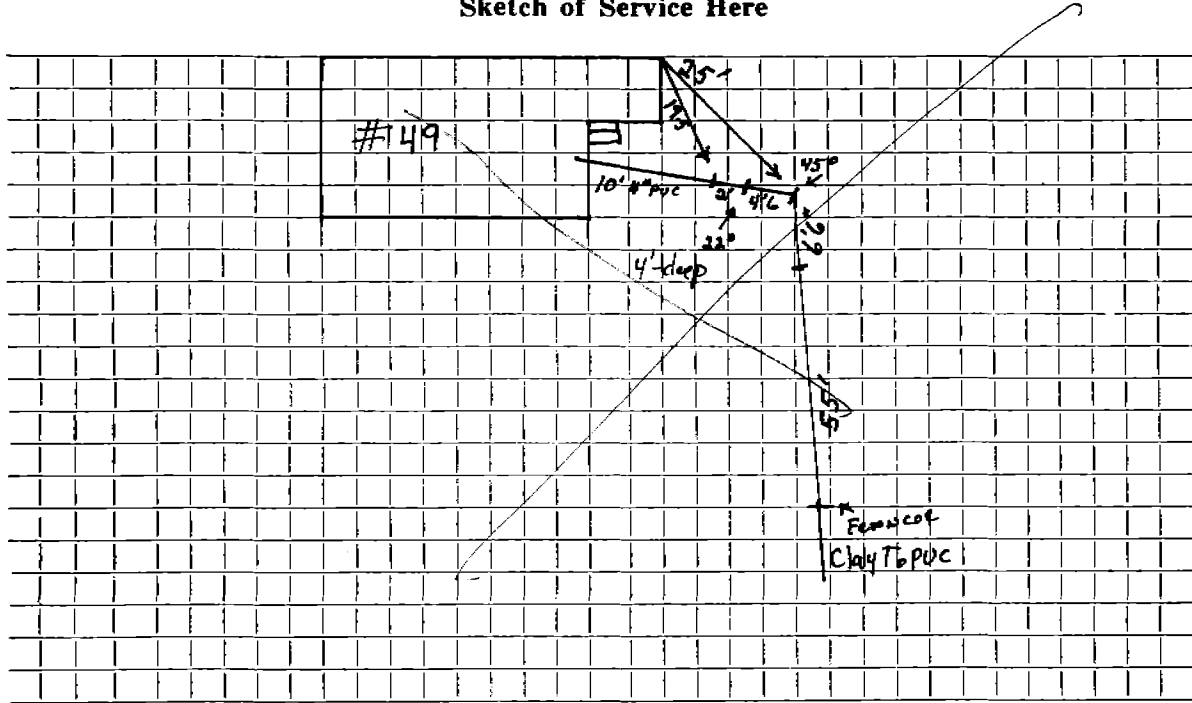

Connection made in Street. Work completed

Remarks:
.....
.....