

Name

Service No.

Address

Lots 100 & 101 Bartlett Avenue

Location

Kind of Pipe

Size

Size of Main

~~Repair~~ ~~Renewal~~ ~~New Service~~ SERVICE IN TO CURB* TO BE CHARGED WHEN
CONNECTED

Location

Date

Material

Amount

Total

Date

Amount

9/29/53

Labor

21 85

10% Overhead

2 19

24 04

22' - 6" sewer pipe @ .3036

6 67

joint compound

1 32

2 hrs. Brox Shovel @ 10.00

20 00

1 hr. allis-chalmers

3 00

1 hr. trucking

75

55 78

Labor

TOWN OF LEXINGTON—DEPT. OF PUBLIC WORKS
SEWER DIVISION

DATE

NO.


The undersigned applies for the construction of a particular sewer connecting No.
Street and hereby agrees to comply with the Rules and Regulations governing the construction and use of Particular
Sewers, as now or at any future time established by the Board of Selectmen.

Am't of estimate \$.....

Am't Paid \$.....

..... Owner

Sketch of Service Here

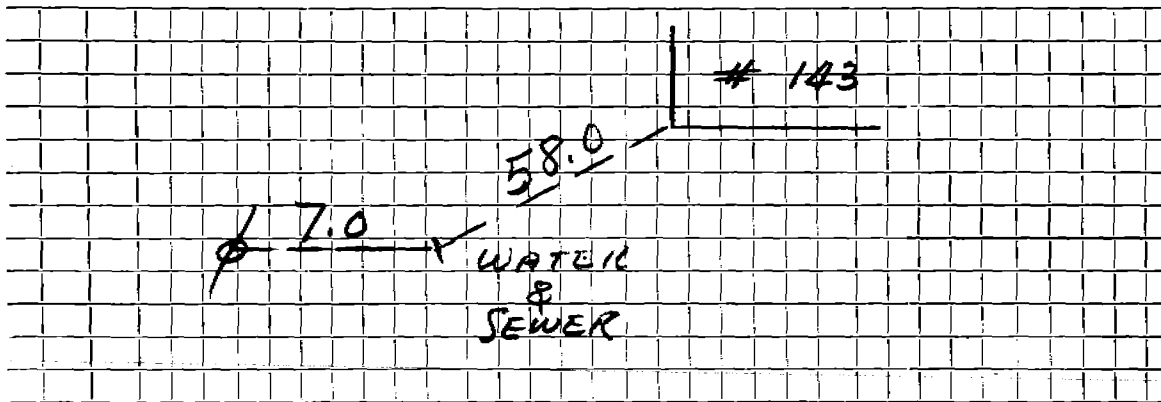

Connection made in Street.

Work completed 19..

Remarks: