

Name Frank Dea

Service No. 235

Address 10 Baskin Road

Location Comm. 3-3-58

Kind of Pipe

Size

Size of Main

Repair—Renewal—New Service

Location

Date	Material	Amount	Total	Date	Amount	
12/31/57	Labor	22 47		12-27-57	Deposit	\$ 130 20
1/2/58	"	14 18		3-3-58	Refund	43 48
		36 65				\$ 106 52
	10% overhead	3 67	40 32			
	50' - 6" Transite Pipe @ .70		35 00			
	2 - 11 $\frac{1}{4}$ " 6" Transite bends @ 5.10		10 20			
	3 hrs. Town Shovel @ 6.50		19 50			
	2 hrs. Trucking @ .75		1 50			
			106 52			
	<b>Labor</b>					

TOWN OF LEXINGTON—DEPT. OF PUBLIC WORKS  
**SEWER DIVISION**

DATE.....

NO. ....

The undersigned applies for the construction of a particular sewer connecting No.....  
Street and hereby agrees to comply with the Rules and Regulations governing the construction and use of Particular  
Sewers, as now or at any future time established by the Board of Selectmen.


Am't of estimate \$.....

Am't Paid \$.....

..... Owner

---

**Sketch of Service Here**

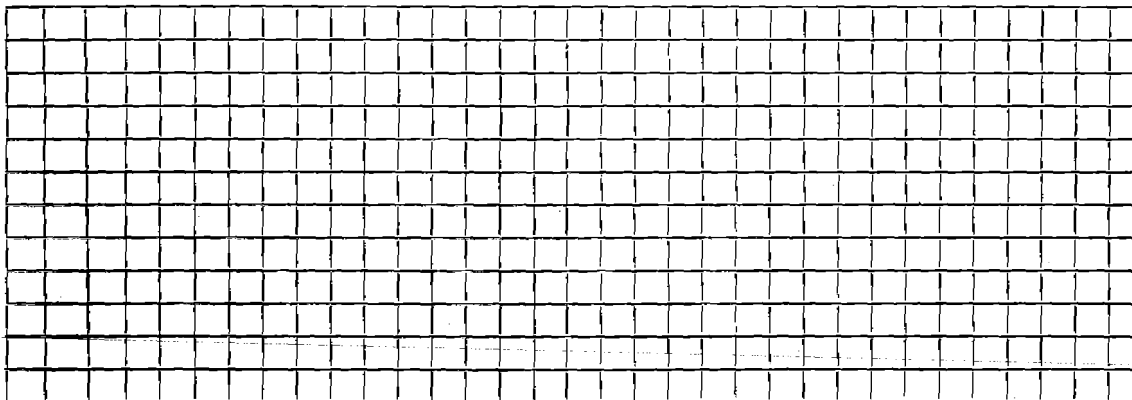

Connection made in..... Street.

Work completed.....19..

Remarks: