

Name Norman Magnanti

Service No. 226

Address 14 Baskin Road

Location

Com m. 3-3-58

Kind of Pipe

Size

Size of Main

Repair—Renewal—New Service

Location

Date	Material	Amount	Total	Date	Amount	
12/27/57	Labor	17 98		12-4-57	<i>Deposit</i>	<i>\$ 150 00</i>
12/31/57	"	7 09		3-3-58	<i>Refund</i>	<i>53 62</i>
		25 07				<i># 96 38</i>
	10% overhead	2 51	27 58			
	61' - 6" Transite Pipe @ .70		42 70			
	1 - 6" 11 $\frac{1}{4}$ " Bend		5 10			
	3 hrs. Town Shovel @ 6.50		19 50			
	2 hrs. Trucking @ .75		1 50			
			96 38			
	Labor					

**TOWN OF LEXINGTON—DEPT. OF PUBLIC WORKS
SEWER DIVISION**

DATE.....

NO.


The undersigned applies for the construction of a particular sewer connecting No.....
Street and hereby agrees to comply with the Rules and Regulations governing the construction and use of Particular
Sewers, as now or at any future time established by the Board of Selectmen.

Am't of estimate \$.....

Am't Paid \$.....

..... Owner

Sketch of Service Here

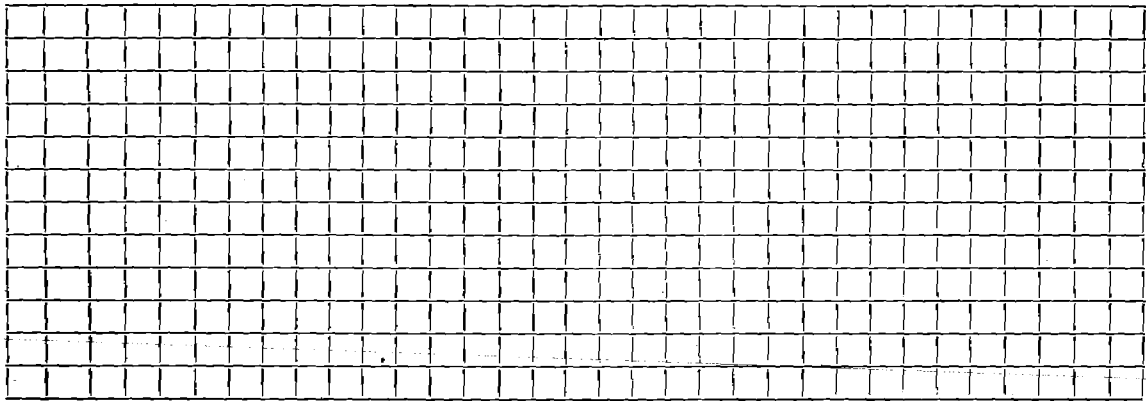

Connection made in..... Street.

Work completed.....19..

Remarks: