


DATE _____

TOWN OF LEXINGTON — BOARD OF PUBLIC WORKS
SEWER DIVISION

Sketch of Service Here **19**

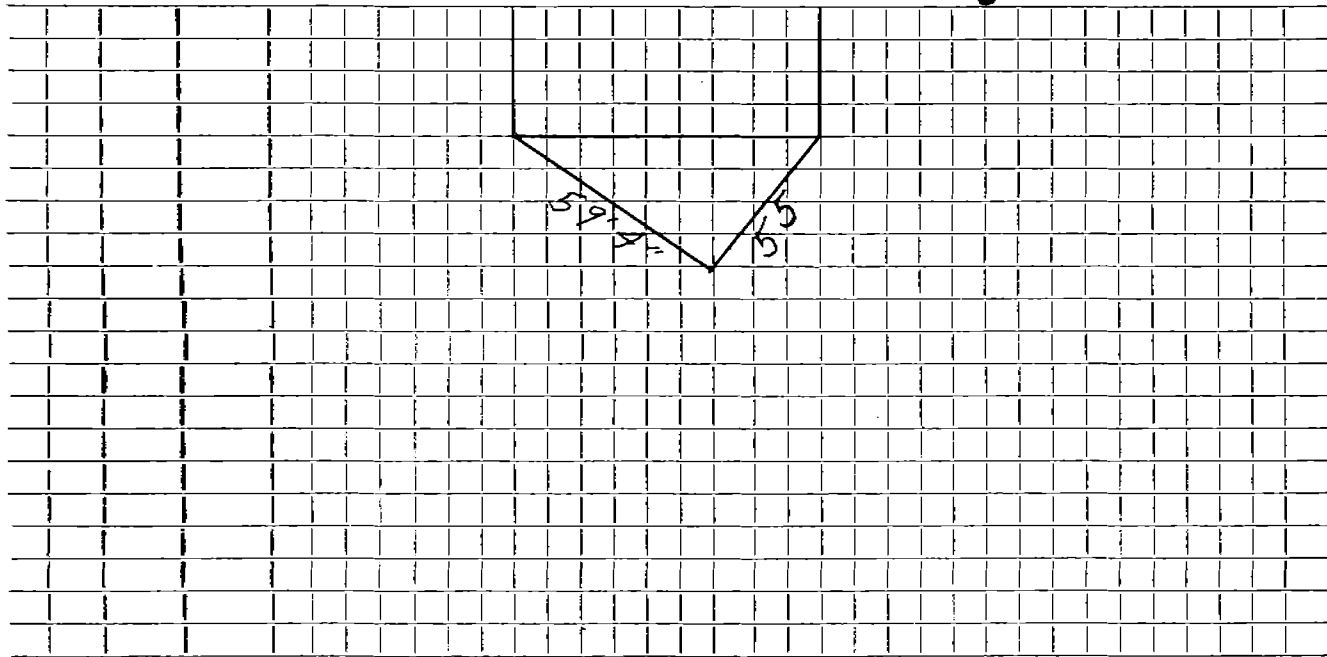

Connection made in Street. Work completed

marks:

.....

.....