

Name Gary Dickerman

Service No.

Address 27 Baskin Road

Location

Lot 13

Kind of Pipe

Size

Size of Main

Repair—Renewal—New Service DeFlice Bros.#1279

Location


Date		Material	Amount	Total	Date		Amount
7-21-69	25'	6" Transite pipe					
	10'	4" Cast Iron pipe					

H.B.M.18501

DATE _____

TOWN OF LEXINGTON — BOARD OF PUBLIC WORKS

SEWER DIVISION

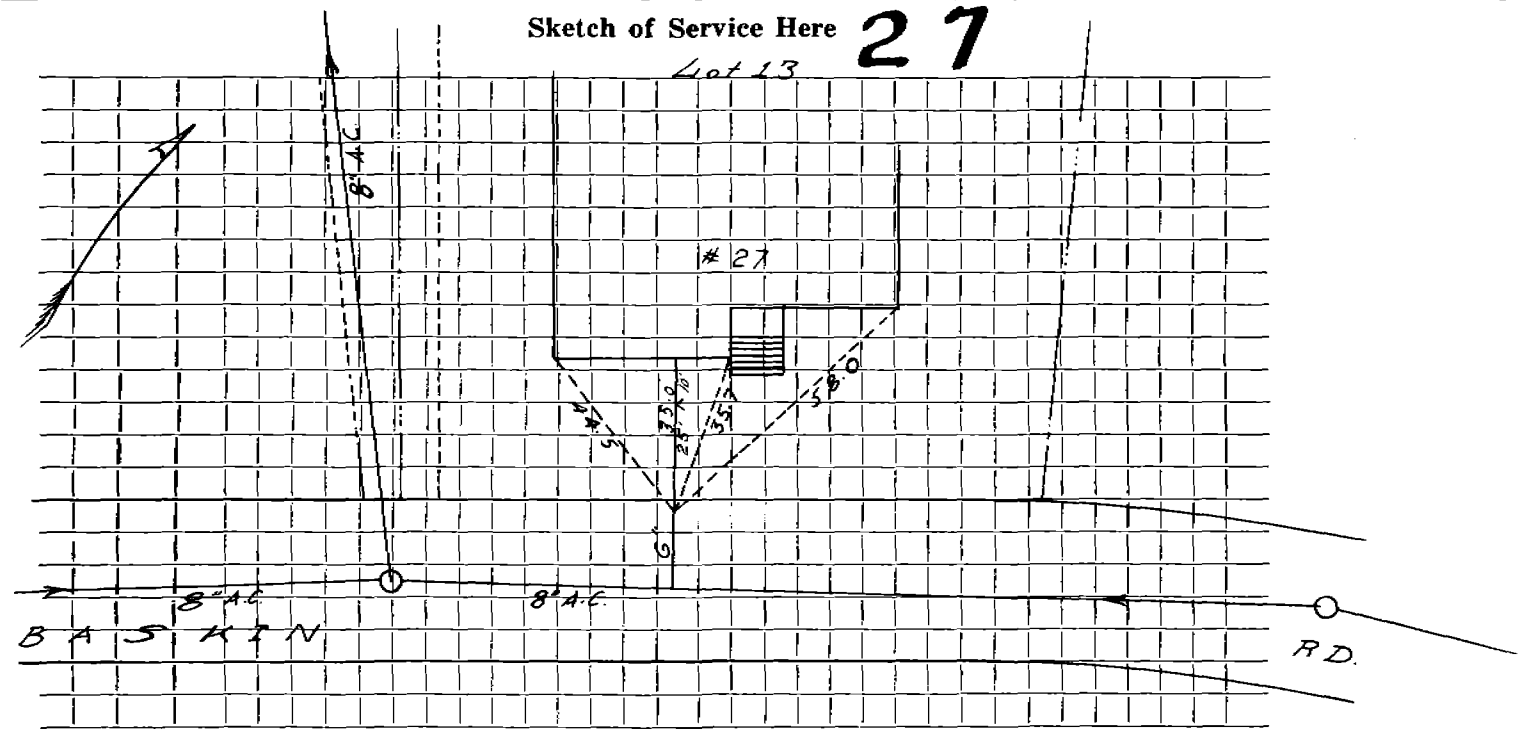

Connection made in Street. Work completed

Remarks:
.....
.....