

Name Core House Corp.

Service No. 123

Address 30 Baskin Road

Location Sta 18/80 Lot #72

Kind of Pipe

Size

Size of Main

~~REPAIR WORK~~ New Service

DeFlice Bros.

Permit #61

Location

Comm 9-21-64


Date	Material	Amount	Total	Date	Amount
7/25/61	Labor	18 35		7-23-64	43 11
	10% O.H.	1 84	20 19		
	19' 6" Transite pipe @.78		14 82		
	1 11 1/4° Transite Bend		5 10		
	1 Hr. Trucking @3.00		3 00		
	BILL WHEN CONNECTED		43 11		
8-10-64	52' 6" Transite pipe				

DATE _____

TOWN OF LEXINGTON — BOARD OF PUBLIC WORKS
SEWER DIVISION

Sketch of Service Here

30

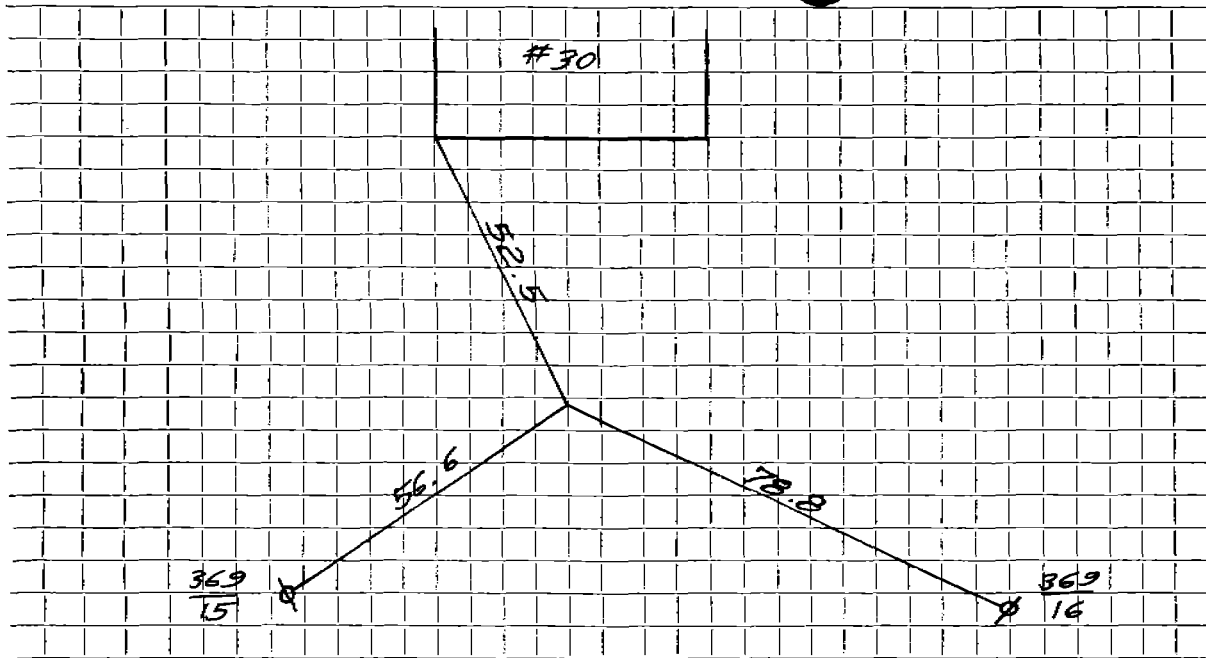

Connection made in Street. Work completed

Remarks:
.....
.....