

Name Core House Corp.

Service No. 83

Address 32 Baskin Road

Location Lot #71 Sta 20/05

Kind of Pipe

Size

Size of Main

~~Repair~~ ~~Renewal~~ — New Service


Location Comm 10-28-63

Date	Material	Amount	Total	Date	Amount
7/26/61	Labor	18 35		7-8-63	250 00
	10% O.H.	1 84	20 19	10-28-63	61 32
	19' 6" Transite Pipe @.78		14 82		188 68
	1 11 1/4" Transite Bend		5 10		
	1 Hr. Trucking @3.00		3 00		
	BILL WHEN CONNECTED		43 11		
7/10/63	Labor	60 12			
	10% O.H.	6 01	66 13		
	50' 6" Transite pipe @.82		41 00		
	1 11 1/4" Transite Bend		4 09		
	1 11 1/4" Transite Elbow		2 35		
	4 Hrs. Town Shovel @6.50		26 00		
	2 Hrs. Trucking @3.00		6 00		
			188 68		

DATE _____

TOWN OF LEXINGTON — BOARD OF PUBLIC WORKS
SEWER DIVISION

Sketch of Service Here **32**

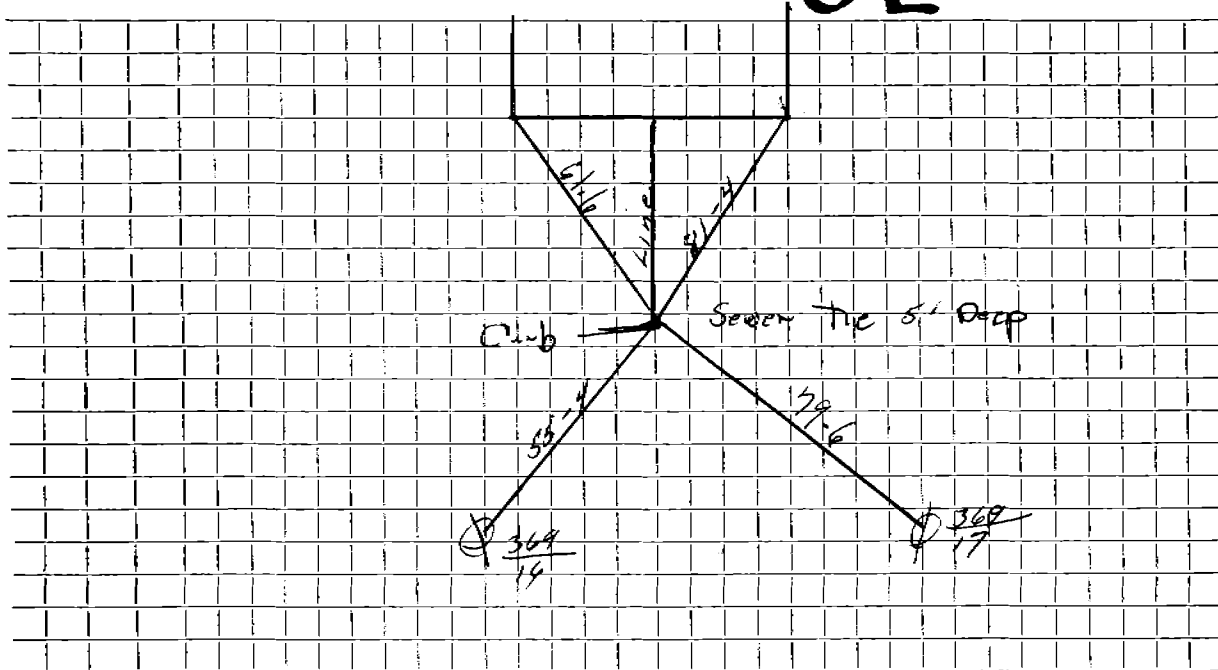

Connection made in Street. Work completed

Remarks:
.....
.....