

Name Ernest Outhet

Service No. 157

Address 34 Baskin Road

Location Lot #70 Sta 21/29

Kind of Pipe

Size

Size of Main

~~Reason for Work~~ New Service

WO # 8270


Location MAR 23 1964

Date	Material	Amount	Total	Date	Amount
7/26/61	Labor	18 35		11-28-63	150 00
	10% O.H.	1 84	20 19	3-23-64	3 19
	19' 6" Transite Pipe @.78		14 82		146 81
	1 11 $\frac{1}{4}$ " Transite Bend		5 10		
	1 Hr. Trucking @3.00		3 00		
	BILL WHEN CONNECTED		13 11		
11/13/63	Labor	37 04			
11/14/63	Labor	6 97			
		44 01			
	10% Overhead	4 40	48 41		
	35' 6" Transite pipe @ .82		28 70		
	1 11 $\frac{1}{4}$ " Transite Bend		4 09		
	3 hrs. Town Shovel @ 6.50		19 50		
	1 hr. Trucking		3 00		
			146 81		

DATE _____

TOWN OF LEXINGTON — BOARD OF PUBLIC WORKS
SEWER DIVISION

Sketch of Service Here **34**

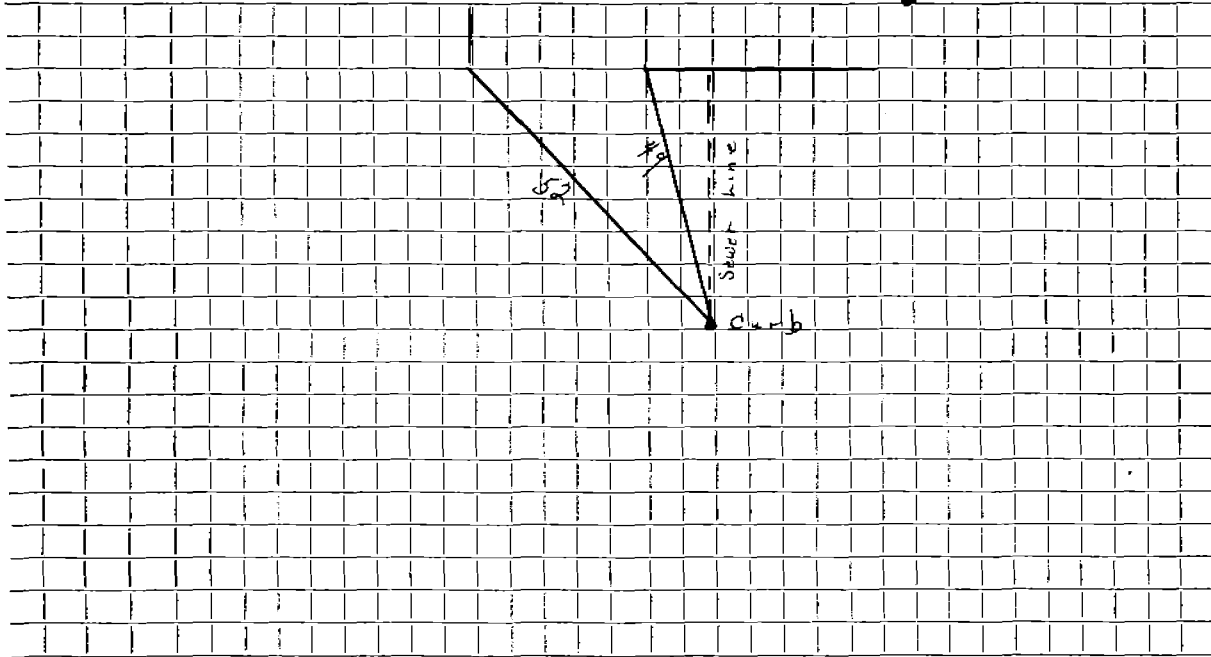

Connection made in Street. Work completed

Remarks:
.....
.....