

Name Jenkins Realty Inc.

Service No.

Address 35 Baskin Road

Lot #77

Location

Kind of Pipe

Size

Size of Main

~~Repair/Replacement~~ New Service Dave Eagle #3591

Location


Date		Material	Amount		Total		Date		Amount	
10-10-80	30'	6" PVC pipe								
	10'	4" CIP								
		5' x 13 Patch Sidewalk								
									OUTSIDE	
							10-10-80	24'	6" P.V.C. pipe	
									8" x 6" Cast Iron Saddle	
									6" x 45° Elbow	
									6' x 16' Patch Outside	

DATE _____

TOWN OF LEXINGTON — BOARD OF PUBLIC WORKS

SEWER DIVISION

Sketch of Service Here **35**

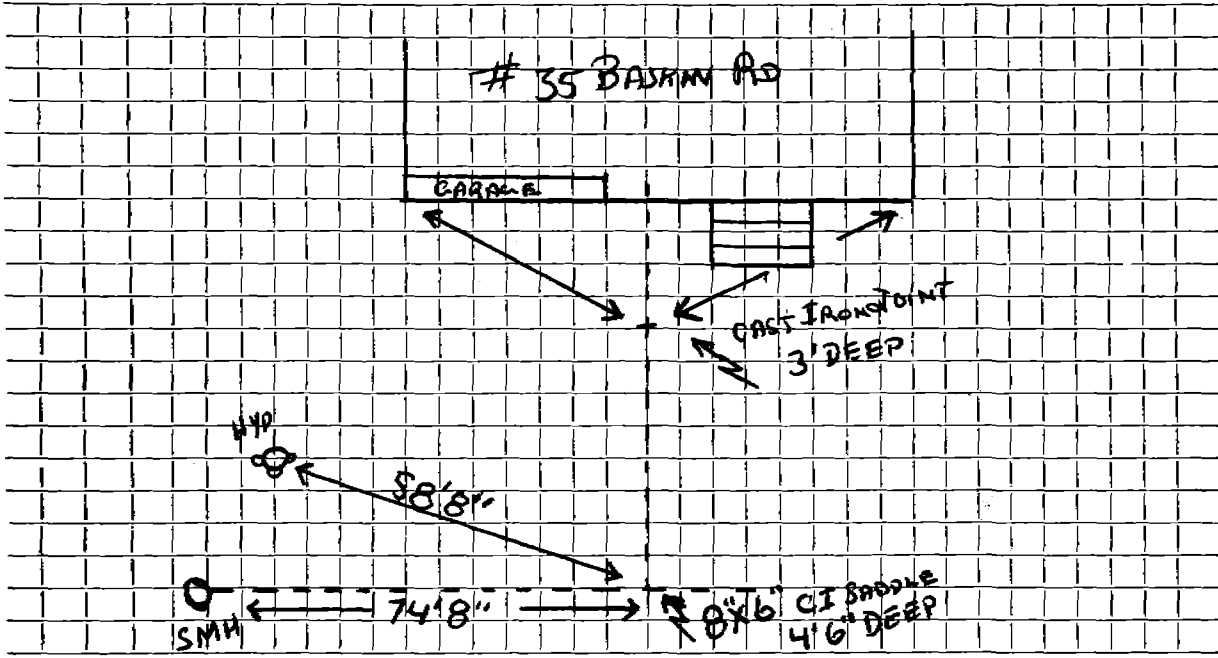

Connection made in Street. Work completed

Remarks:
.....
.....