

Name Raymond Boudreau

Service No. 145

Address 41 Baskin Road

Lot #79 Sta 21480

Location

Kind of Pipe

Size

Size of Main

~~Repair~~ ~~Renewal~~ - New Service

No 7598

Location

Cement 12-10-62



Date	Material	Amount	Total	Date	Amount
7/26/61	Labor	6 18		3 Bags Cement @1.50	4.50
	10% O.H.	62	6 80	1 M. H. Cover & Frame	35.00
	64' 6" Transite pipe @.78		49 92	4 Hrs. Trucking @3.00	12.00
	1 11 $\frac{1}{4}$ " Transite Bend		5 10	6 Hrs. Pumping @1.00	6.00
	1 22 $\frac{1}{8}$ " Transite Bend		6 21	3 Hrs. Town Shovel @6.50	19.50
	1 Hr. Trucking @3.00		3 00		481.68
	BILL WHEN CONNECTED		71 03		
9-25-62	Labor 62.94			7-13-62 Deposit	250 00
10-15-62	" 77.09			12-10-62 Paid by utility #1122	17 06
10-16-62	" 25.78			12-19-62	285 65
10-17-62	" 16.88	182.69			
	10% O.H.	18.27	200.96		
	216' 6" Transite pipe @82		177.12		
	1 6" Duplex Adapter		1.62		
	1 11 $\frac{1}{4}$ " Transite Bend		4.09		
	1 90° Transite Elbow		4.09		
	1.00 Sewer Brick @4.20 per 100		16.80		

DATE _____

TOWN OF LEXINGTON — BOARD OF PUBLIC WORKS

SEWER DIVISION

Sketch of Service Here **41**

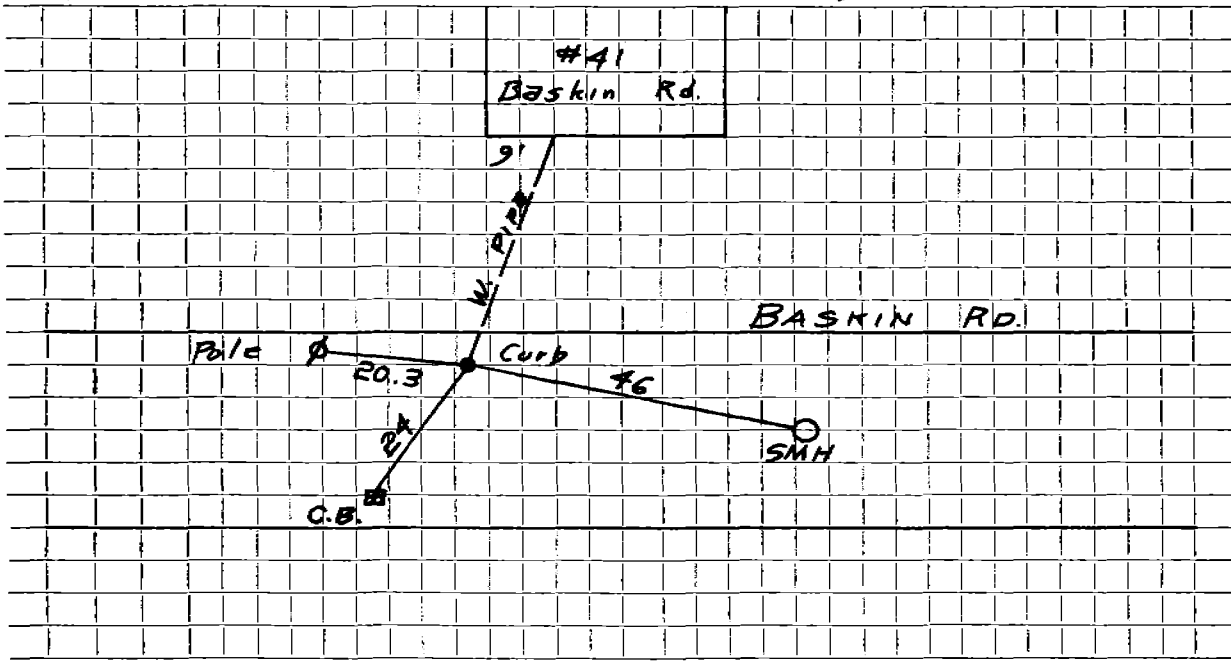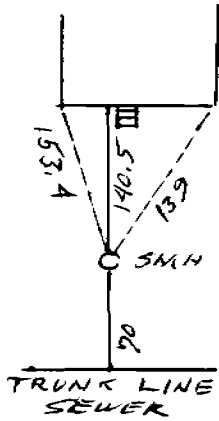

Connection made in Street. Work completed

Remarks:
.....
.....