




DATE \_\_\_\_\_

TOWN OF LEXINGTON — BOARD OF PUBLIC WORKS  
SEWER DIVISION

Sketch of Service Here **48**

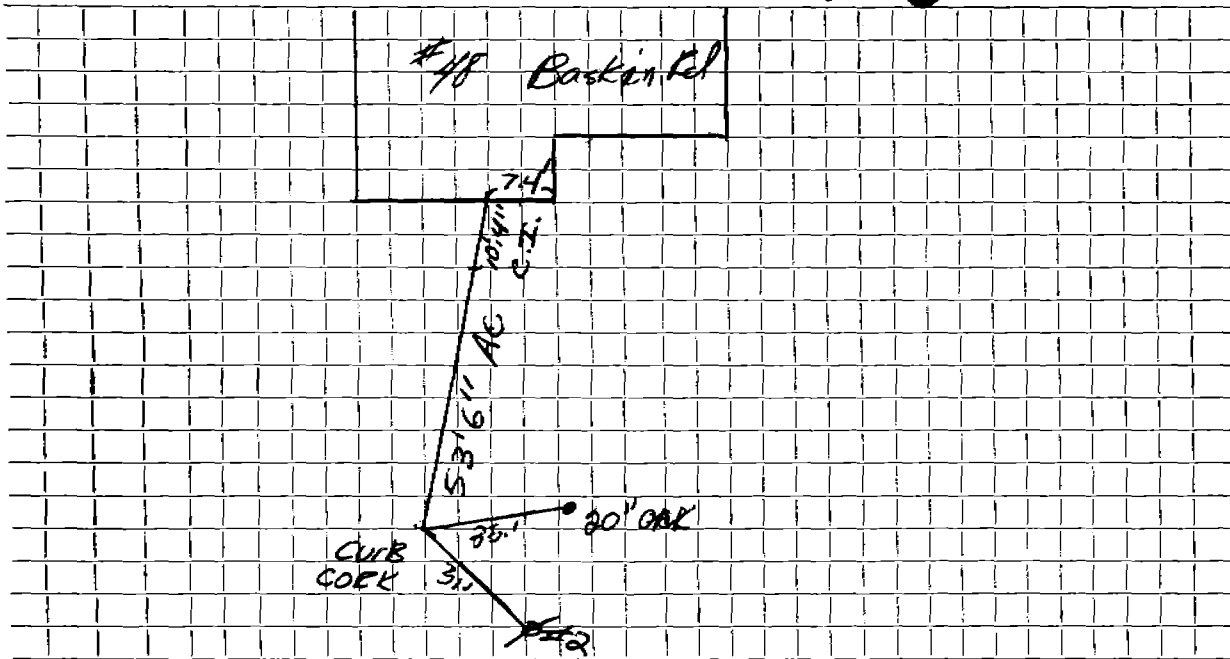

Connection made in ... 48 Baskin Rd Street.

Work completed ... 6/2/76 .....

Remarks: ~~.....~~  
.....  
.....