

Name Mark Moore

Service No. 26

Address 5 Baskin Road

Location Comm. 6-2-58

Kind of Pipe

Size

Size of Main

~~Repair~~ ~~Renewal~~ ~~New Service~~

Location

Date	Material	Amount	Total	Date	Amount
3/12/58	Labor	16 18		3-10-58	Deposit \$ 50 20
	10% overhead	1 62	17 80	6-2-58	Pd. by ref of W.H.C. #25 17 55
	50' - 6" Transite pipe @ .70		35.00		
	1 - 11 $\frac{1}{4}$ " Transite Elbow		2 24	6-10-58	Paid 1 99
	2 hrs. Town Shovel @ 6.50		13 00		\$ 69 54
	2 hrs. Trucking @ .75		1 50		
			69.54		

Labor

**TOWN OF LEXINGTON—DEPT. OF PUBLIC WORKS**  
**SEWER DIVISION**

DATE.....

NO. ....

The undersigned applies for the construction of a particular sewer connecting No.....  
Street and hereby agrees to comply with the Rules and Regulations governing the construction and use of Particular  
Sewers, as now or at any future time established by the Board of Selectmen.


Am't of estimate \$.....

Am't Paid \$.....

..... Owner

---

**Sketch of Service Here**

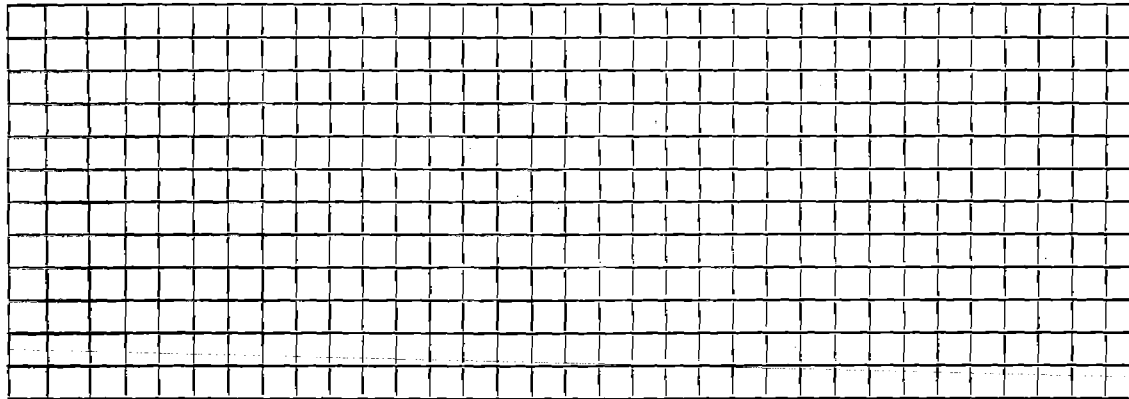

Connection made In..... Street.

Work completed.....19..

Remarks: