

Name

Service No.

Address 53 BASILIN

Location

Kind of Pipe SDR 35

Size 6" PVC

Size of Main

Repair ~~Renewal~~ New Service

Location

Date

Material

Amount

Total

Date

Amount

11/2016

6" SDR


11/2016

6" FURNCO

DATE 11/2016

TOWN OF LEXINGTON — BOARD OF PUBLIC WORKS
~~SEWER~~
~~SEWER~~
~~WATER~~ DIVISION

Sketch of Service Here

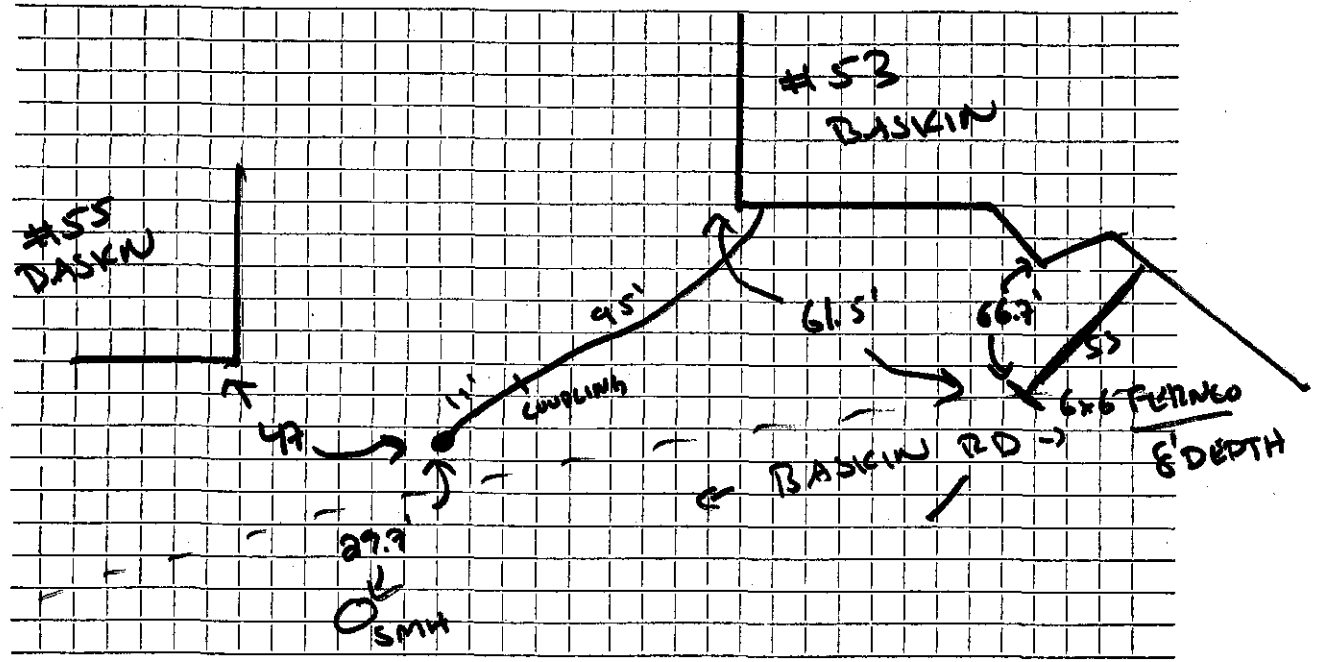

Connection made in Street. Work completed

Remarks:
.....
.....