

Name Arthur T. Berwier

Service No. 58

Address 54 Baskin Road

Lot # ~~62~~ 62

Location

Kind of Pipe

Size

Size of Main

~~Repair - Renewal - New Service~~

Location Comm 6-19-61

XXXXXXXXXXXXXXXX


Date	Material	Amount	Total	Date	Amount
5-20-60	Labor	10.88		5-25-61	250.00
	10% O.H.	1.09	11.97	6-19-61	83.91
	26' 6" Transite pipe @.78		20.28		166.09
	1 hr. Trucking @3.00		3.00		
	<u>BILLWHEN CONNECTED</u>		35.25		
6-6-61	Labor	42.58			
	10% O.H.	4.26	46.84		
	75' 6" Transite pipe @.78		58.50		
	3 Hrs. Town Shovel @6.50		19.50		
	2 Hrs. Trucking @3.00		6.00		
			166.09		

\* Apply 4110 to W/C #66

DATE \_\_\_\_\_

**TOWN OF LEXINGTON — BOARD OF PUBLIC WORKS**  
**SEWER DIVISION**

#54 Sketch of Service Here **54**

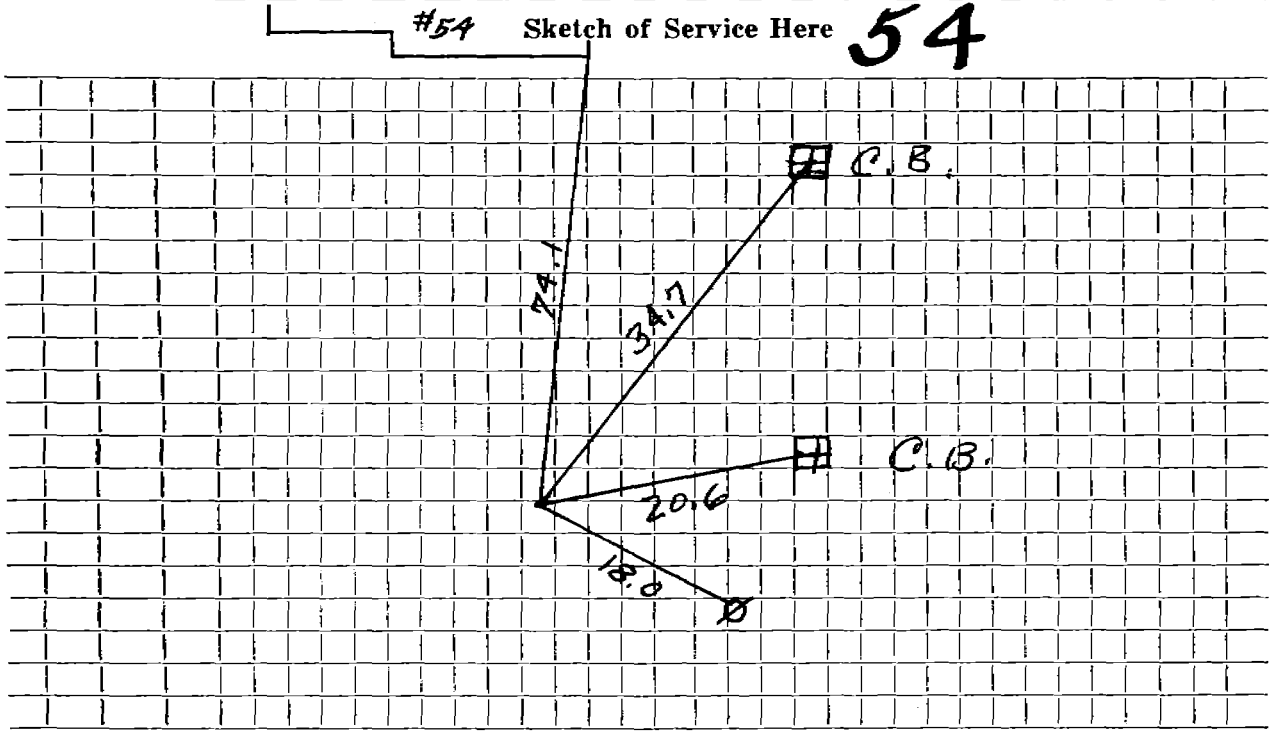

Connection made in ..... Street. Work completed .....

Remarks: .....  
.....  
.....