

Name Lexington Development Corp.

Service No. 10

Address 6 Baskin Road

Location Comm. 6-2-58

Kind of Pipe

Size

Size of Main

~~Repair~~ ~~Renewal~~ ~~New Service~~

Location

Date	Material	Amount	Total	Date	Amount
2/11/58	Labor	14 18		1-23-58 Deposit	\$ 150 20
3/13/58	"	63 88		6-13-58 Pd. by ref of S.W.C#9	23 50
		78 06		6-13-58 Pd. " " " W.W.C#11	20 07
	10% overhead	7 81	85 87	6-13-58 " " " " W.W.C#12	2 95
	69' - 6" Transite Pipe @ .70		48 30		\$ 196 42
	9 ton 1 1/4" Stone @ 1.50		13 50		
	6 hrs. Town Shovel @ 6.50		39 00		
	1 hr. Trucking		3 00		
	1 hr. Trucking		75		
	3 hrs. Jager Pump @ 1.00		3 00		
	1 hr. Rodgers Trailer		3 00		
			196 42		
	Labor				

TOWN OF LEXINGTON—DEPT. OF PUBLIC WORKS
SEWER DIVISION

DATE.....

NO.


The undersigned applies for the construction of a particular sewer connecting No.....
Street and hereby agrees to comply with the Rules and Regulations governing the construction and use of Particular
Sewers, as now or at any future time established by the Board of Selectmen.

Am't of estimate \$.....

Am't Paid \$.....

..... Owner

Sketch of Service Here

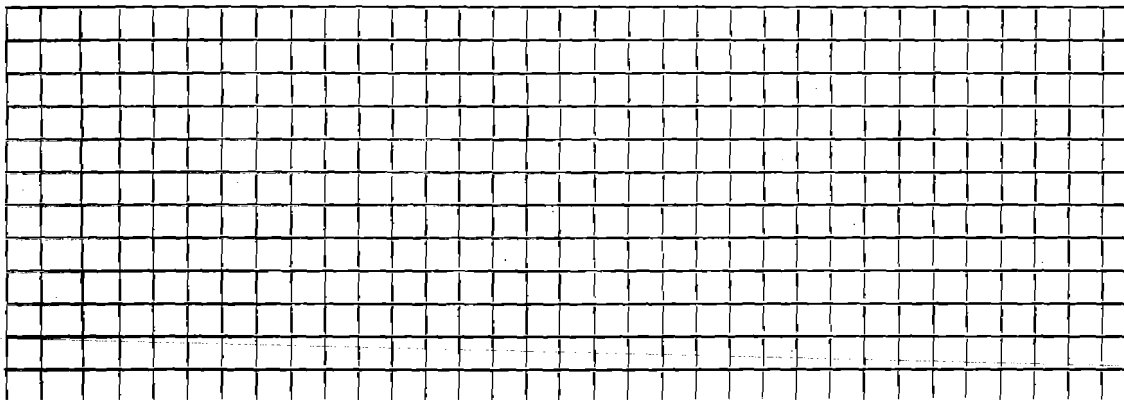

Connection made in..... Street.

Work completed.....19..

Remarks: