

Name Parker Herlite

Service No. 168

Address 62 Baskin Road

Lot #58

Location

Kind of Pipe

Size

Size of Main

~~X Repair~~ ~~X Renew~~ ~~X~~ New Service

Kirkland and Shaw # 505


Location *Comp # 5-8-67*

Date	Material	Amount	Total	Date	Amount
5-21-60	Labor	10.88		<i>12-13-64</i>	<i>32.55</i>
	10% O.H.	1.09	11.97		
	16' 6" Transite pipe @.78		12.48		
	1 11 $\frac{1}{4}$ " Transite Bend		5.10		
	1 hr. Trucking @3.00		3.00		
	<u>BILL WHEN CONNECTED</u>		<u>32.55</u>		
12/15/66	40' 6" Transite 10' 4" Cast Iron				

DATE \_\_\_\_\_

**TOWN OF LEXINGTON — BOARD OF PUBLIC WORKS**  
**SEWER DIVISION**

Sketch of Service Here **62**

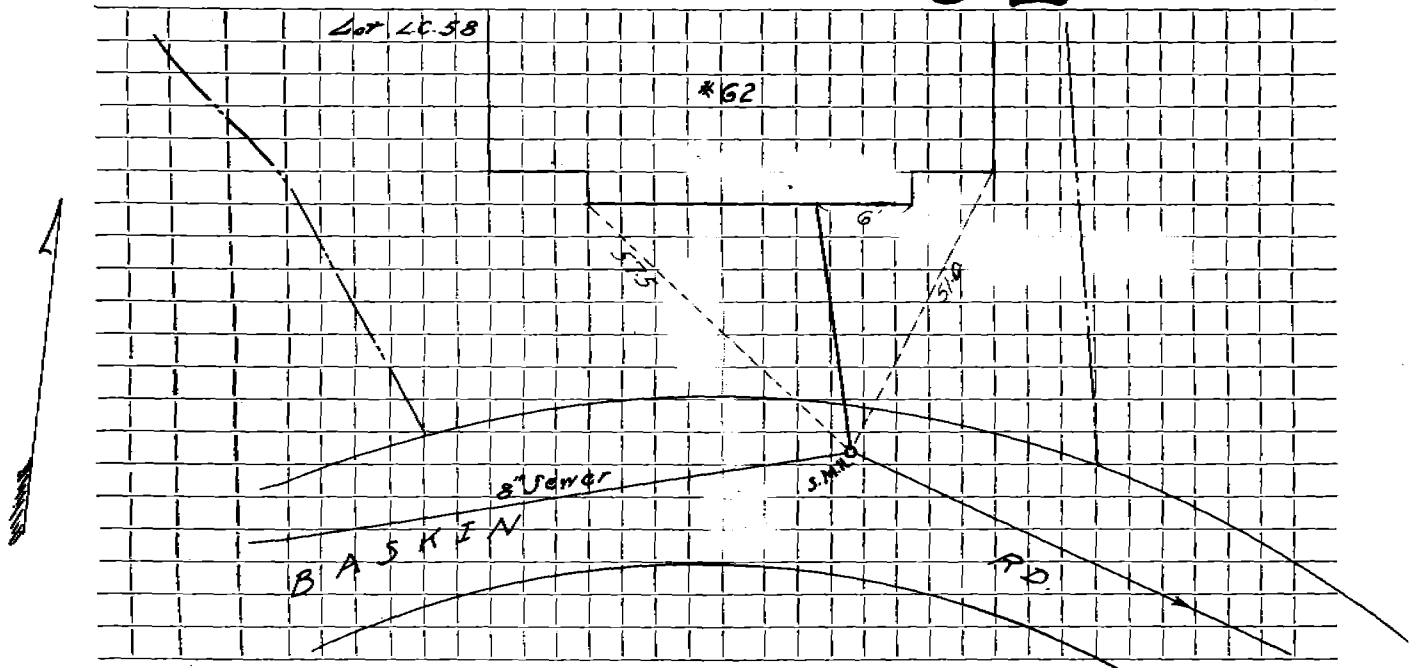

Connection made in ..... Street. Work completed .....

Remarks: .....  
.....  
.....

LORING RD